


T.17S. R20E. W.M.

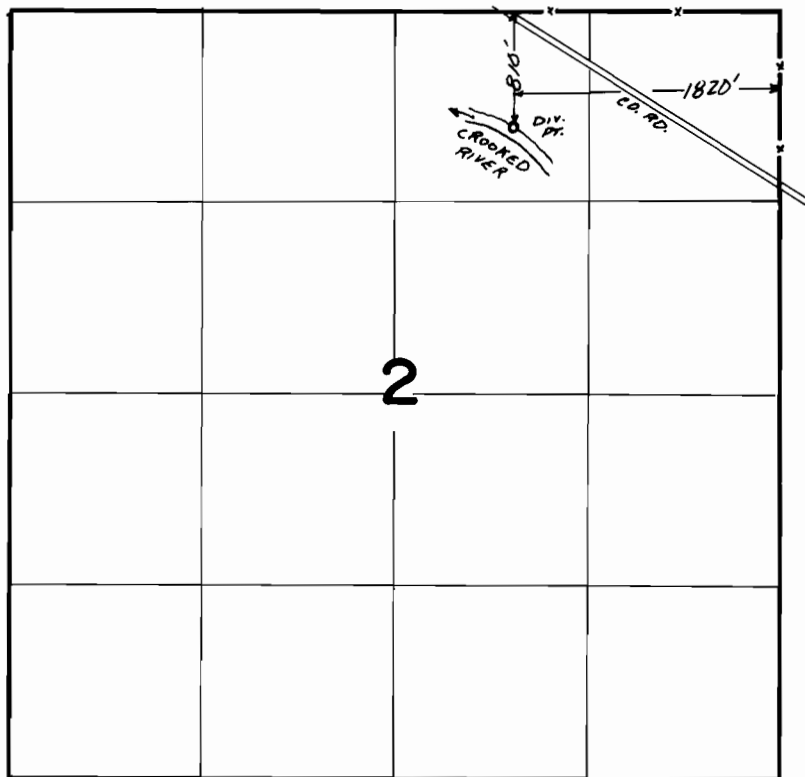

FINAL PROOF SURVEY
UNDER

Transfer No. 2684..... Permit No.
IN NAME OF

.....**MILLER TWEEDT**.....

Surveyed Aug. 4, 1977, by D.M. Norby.....