


T.17S., R.20E., W.M.

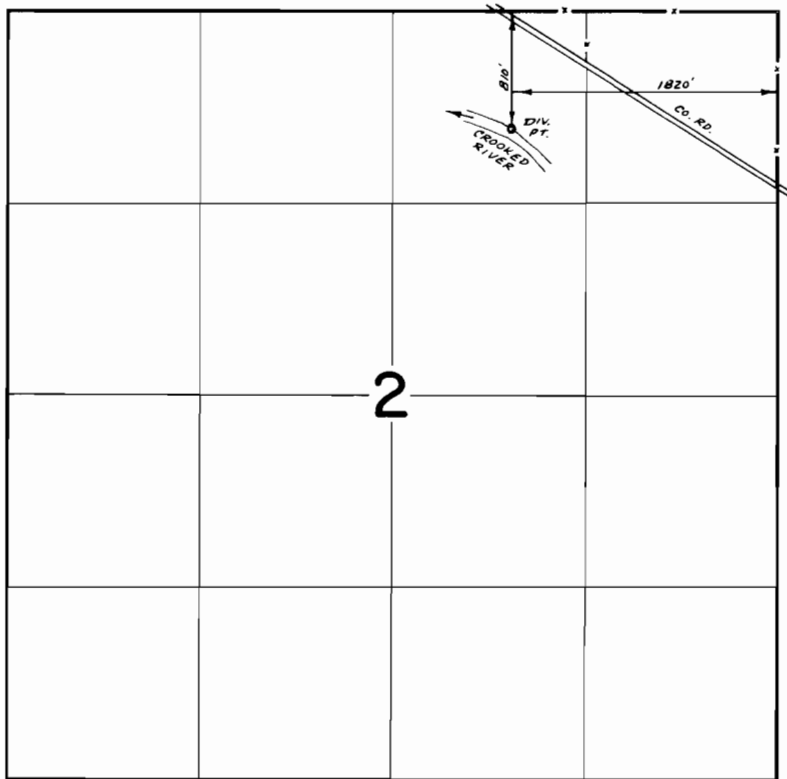

FINAL PROOF SURVEY
UNDER

Transfer No. 2685
Application No. Permit No.
IN NAME OF

ALASKA PACIFIC LUMBER CO.

Surveyed May 13 1975, by D. Norby