


T.5S. R.5W. W.M.

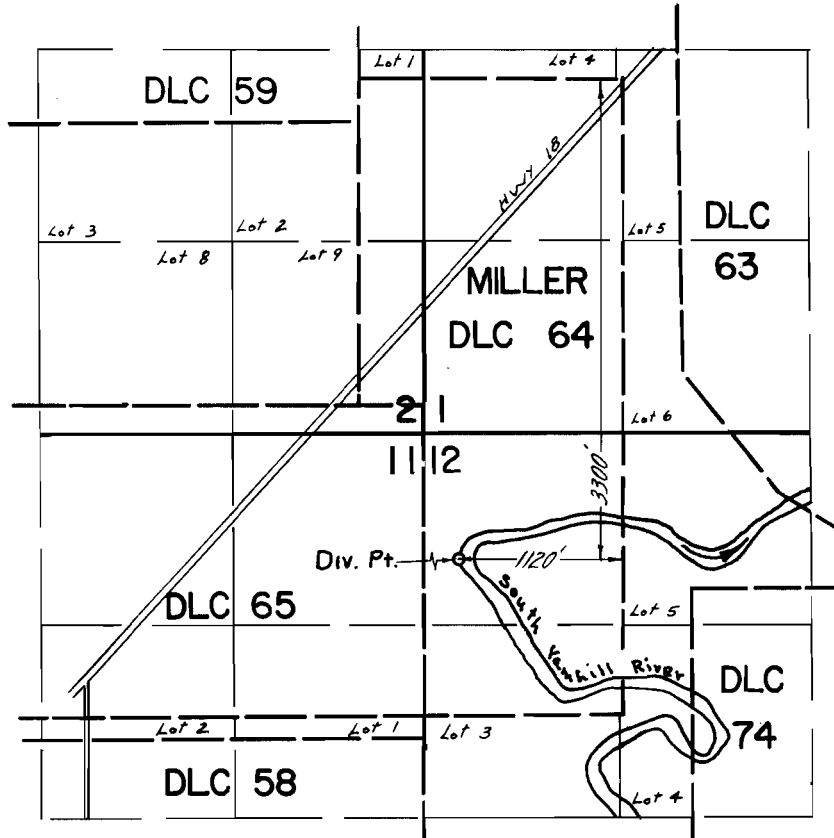

FINAL PROOF SURVEY
UNDER

TRANSFER NO. 2686

Application No. _____ Permit No. _____

IN NAME OF

EZEKIEL WILLIAMS

Surveyed MAY 30, 1973, by R. G. MUCKEN