


T.35S., R.3W., W.M.

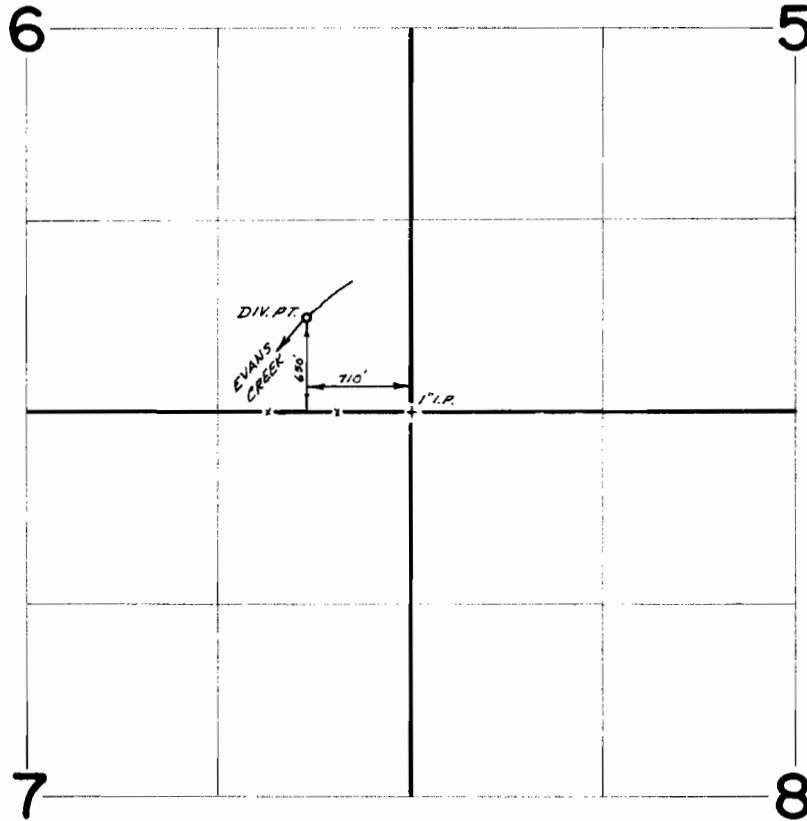

**FINAL PROOF SURVEY**  
UNDER

Transfer No. 2697

Application No. \_\_\_\_\_ Permit No. \_\_\_\_\_

IN NAME OF

WILLIAM L. AND DOLORES M. TAYLOR

Surveyed May 2 1975, by D. Norby