


T.9S. R.1E. W.M.

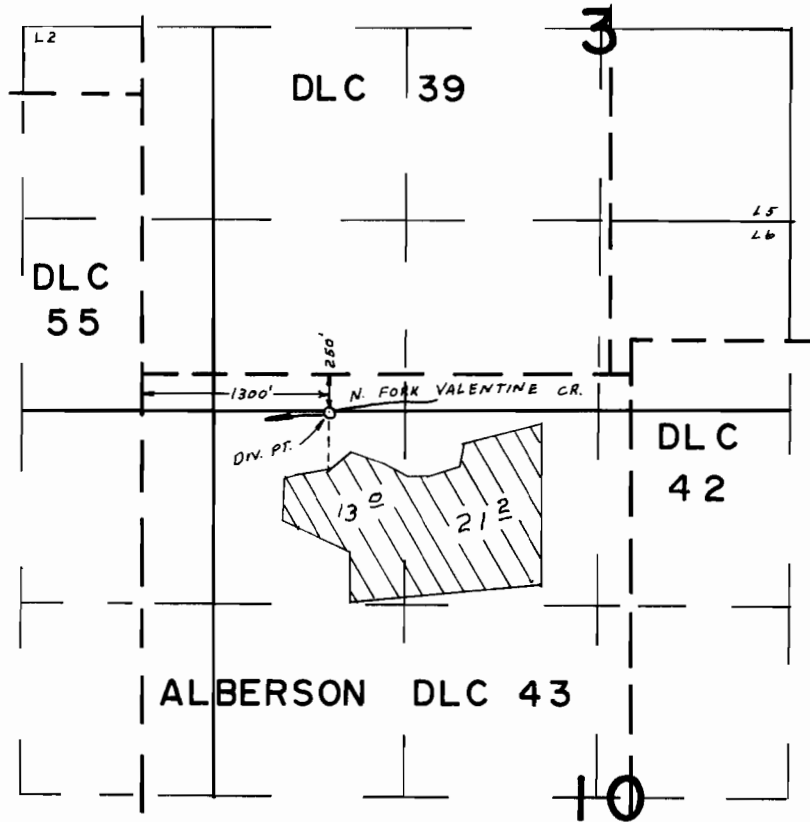

FINAL PROOF SURVEY UNDER

Transfer No. 2714

Application No. Permit No.
IN NAME OF

ETZEL BROTHERS

Surveyed JUL 5 1974, by LH NUNN