


T.2N., R.10E., W.M.

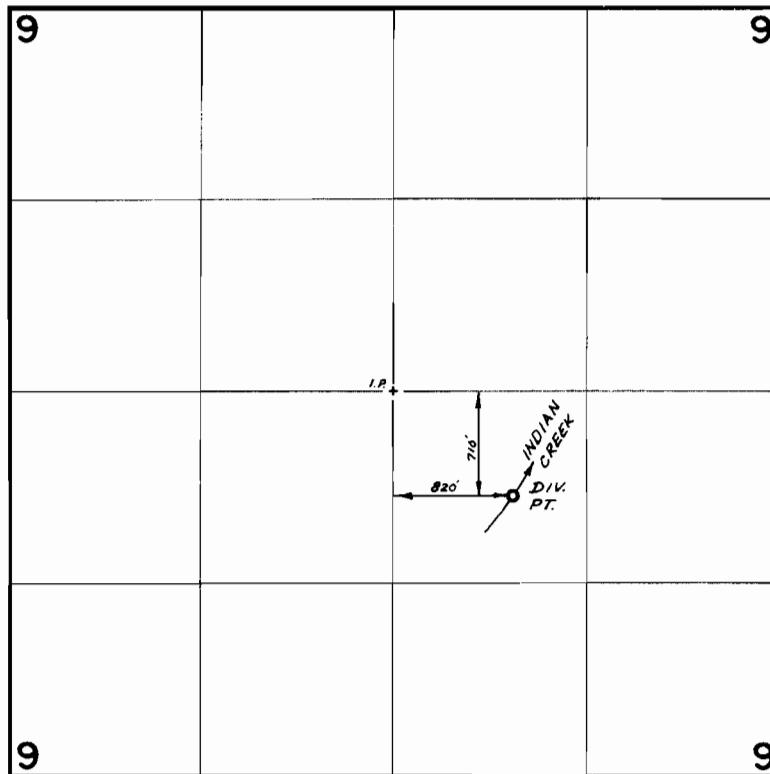

FINAL PROOF SURVEY
UNDER

Transfer No. 2716
Application No. Permit No.
IN NAME OF

.....
WALLACE JOHNSON
.....

Surveyed April 15 1975, by D. Norby