


# T.17S.,R.15E.,W.M.

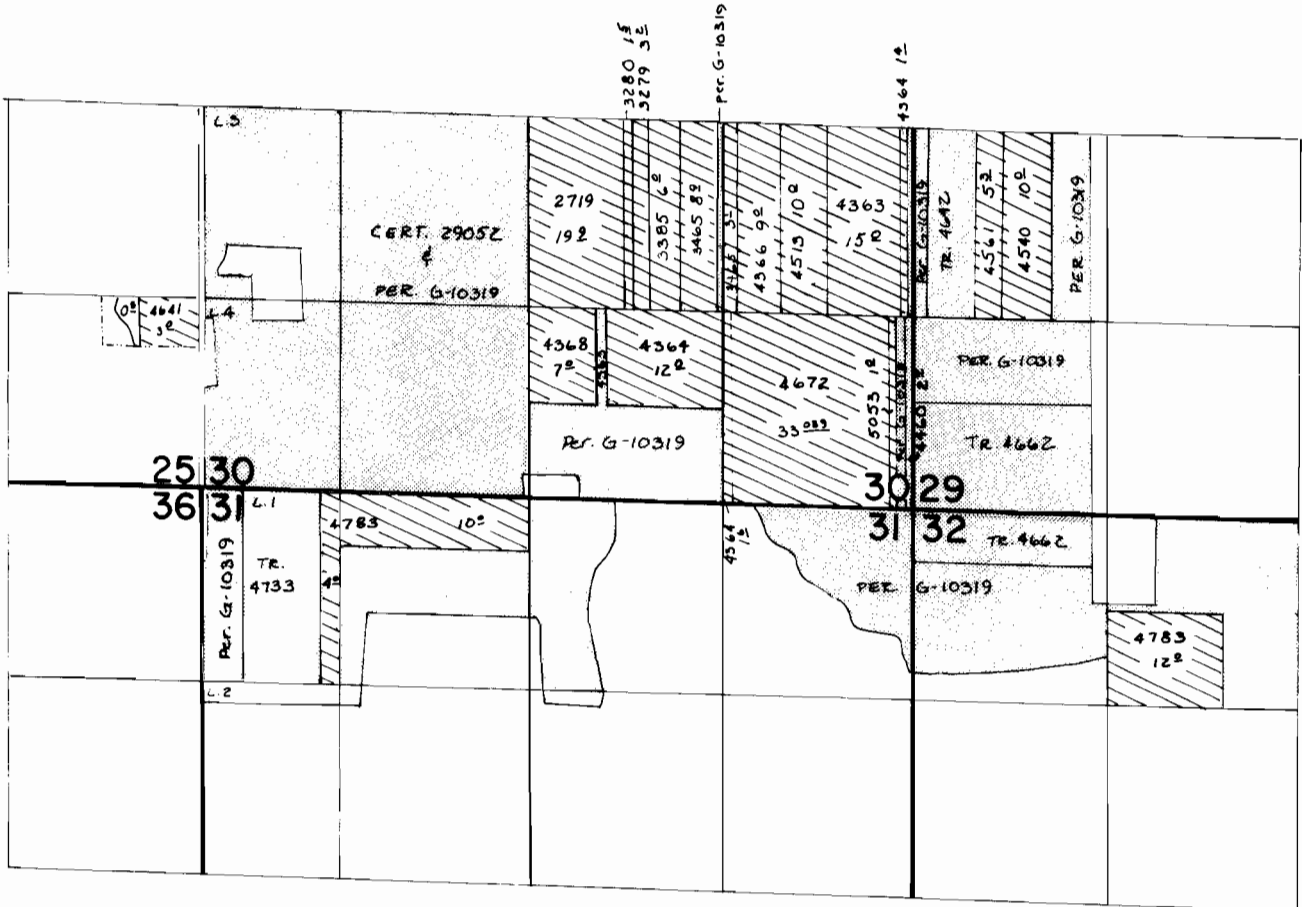

SCALE : 1" = 1320'

## FINAL PROOF SURVEY

UNDER

Transfers

2719, 3275, 3280, 3385, 4363, 4364, 4366, 4368,  
4513, 4540, 4561, 4641, 4672, 4783, 5053, 3465

Application No. .... Permit No. ....

IN NAME OF

**WAYNE P. SINGHOSE**

Surveyed SEPT. 4, 1984, by L. OLSON

