


T.13 S. R.4 W. W.M.

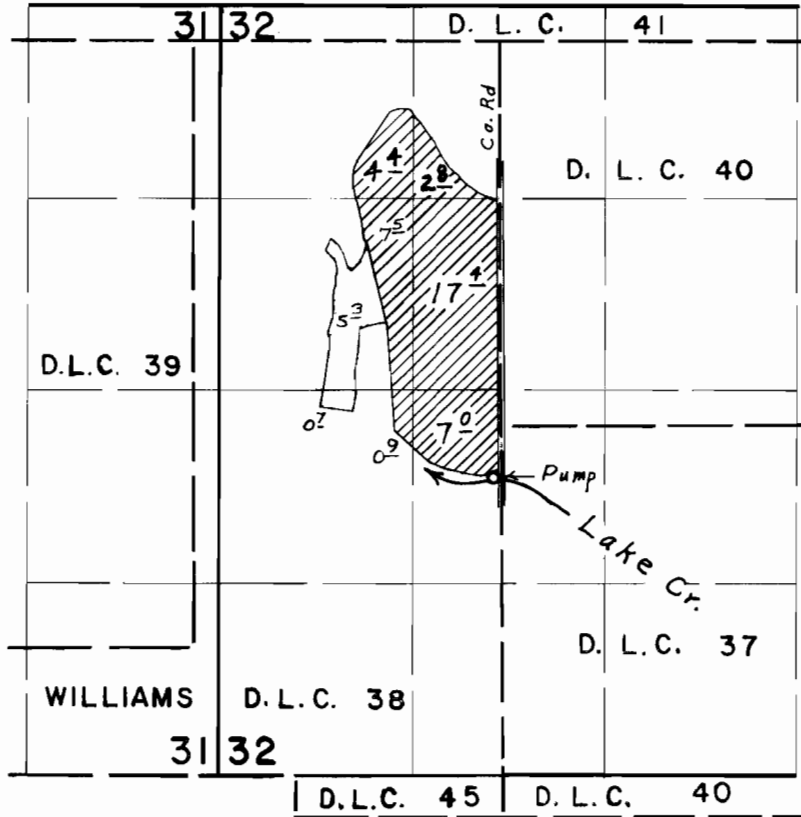

FINAL PROOF SURVEY UNDER

Application No. _____ Transfer No. 2732
 Permit No. _____
 IN NAME OF

MUDDY CREEKS IRRIGATION PROJECT

Surveyed Oct. 14, 1974, by Larry M. Toll