


T.14 S. R.39 E. W.M..

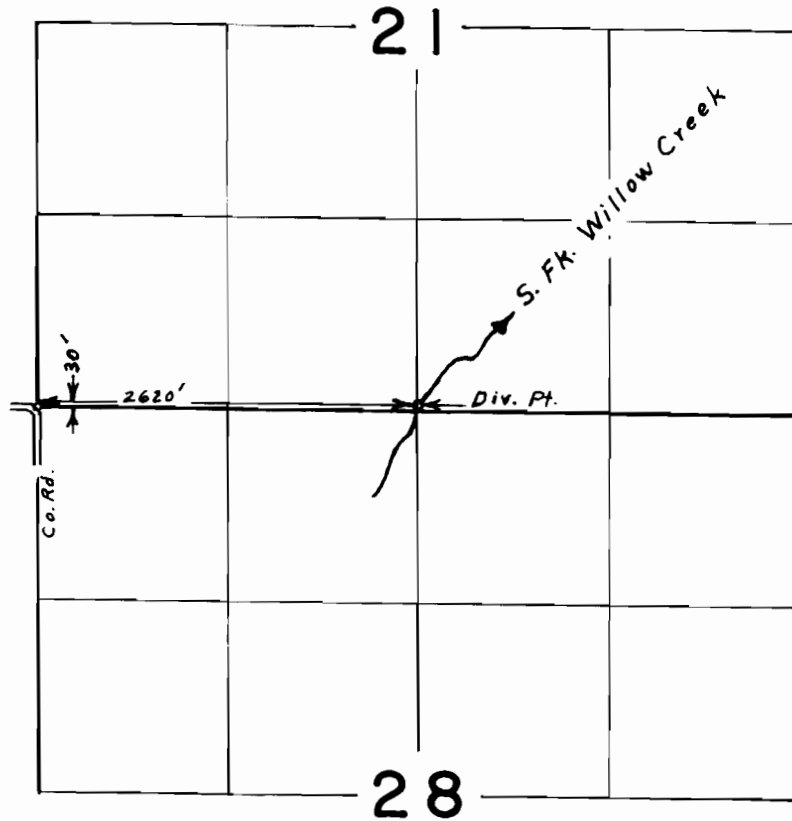

**FINAL PROOF SURVEY**  
UNDER

Application No. .... Transfer No. 2735  
..... Permit No. ....  
IN NAME OF  
**JOHN MOLTHAN**

Surveyed April 28, 1976, by L. E. Gould