



T. 39 S., R. 2 & 3 W., W. M.

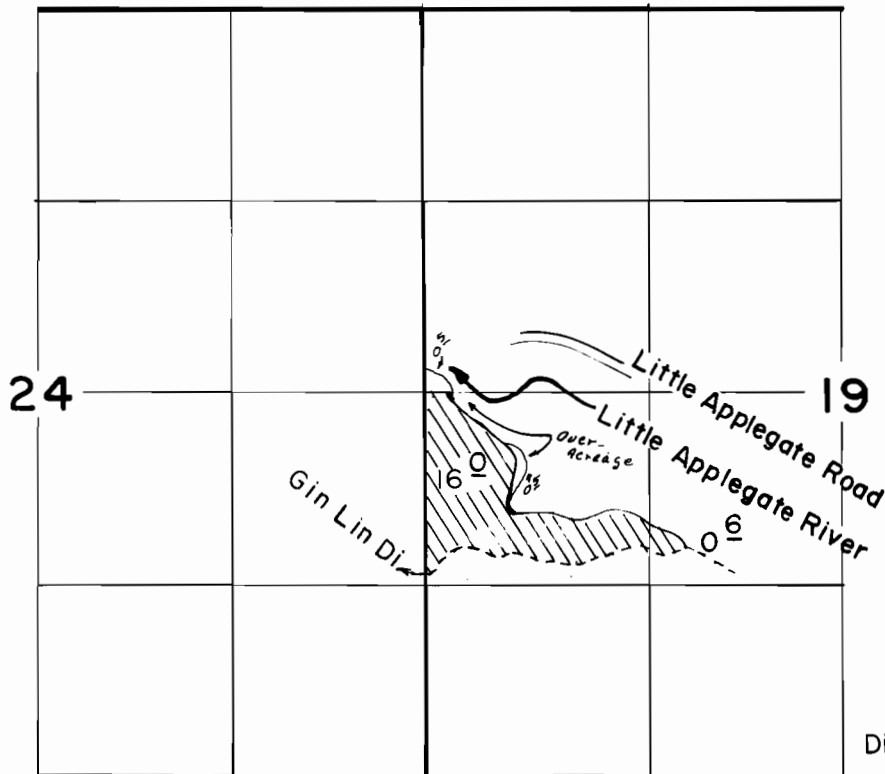

Div. Pt. Gin Lin Ditch
T. 39S., R. 2W., W. M.

Scale: 1" = 1320'

Little Applegate River

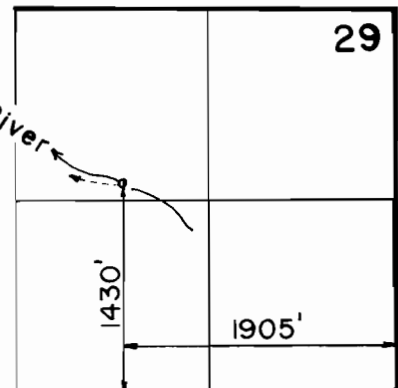

FINAL PROOF SURVEY

UNDER

TRANSFER NO. 2745

Application No. Permit No.

IN NAME OF

..... STUART V. HINSON

Surveyed JUL. 9. 1986, by B. S. JAMES.