


T. 2N., R. 27E., W. M.

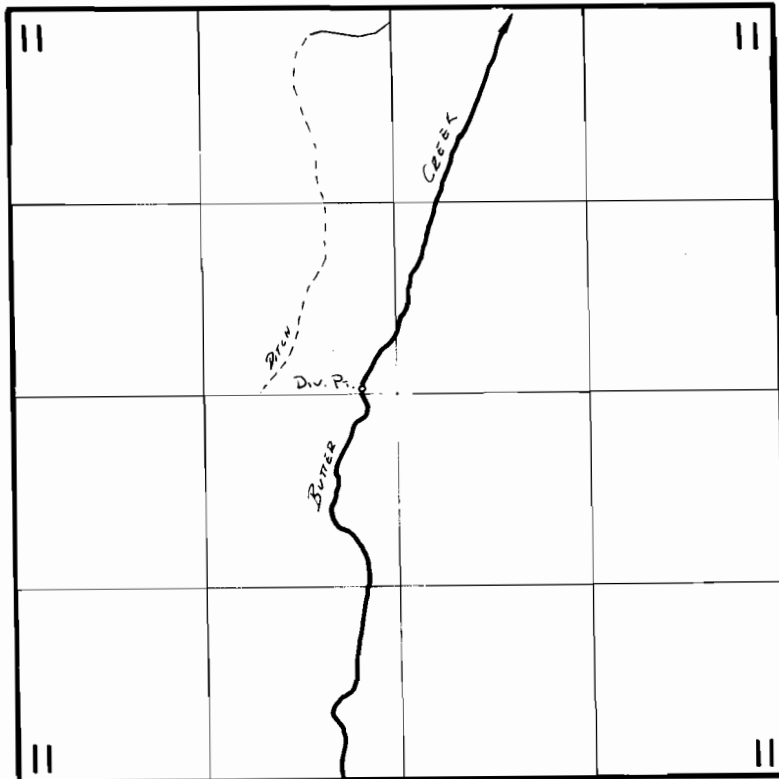

*Div. Pt. Loc. 40' N. + 240' W. FROM CENTER COR. SEC. 11*

**FINAL PROOF SURVEY**  
UNDER

**TRANSFER 2748**

Application No. .... Permit No. ....  
IN NAME OF

.....**GLENN M. COCHRAN**.....

Surveyed *May 7*..... 19*75*., by *R. Muchan*.....  
*Jan. 16 1979 R. Barwin*  
*July 28 1983 V. L. Church*