


T. 1N., R. 4W

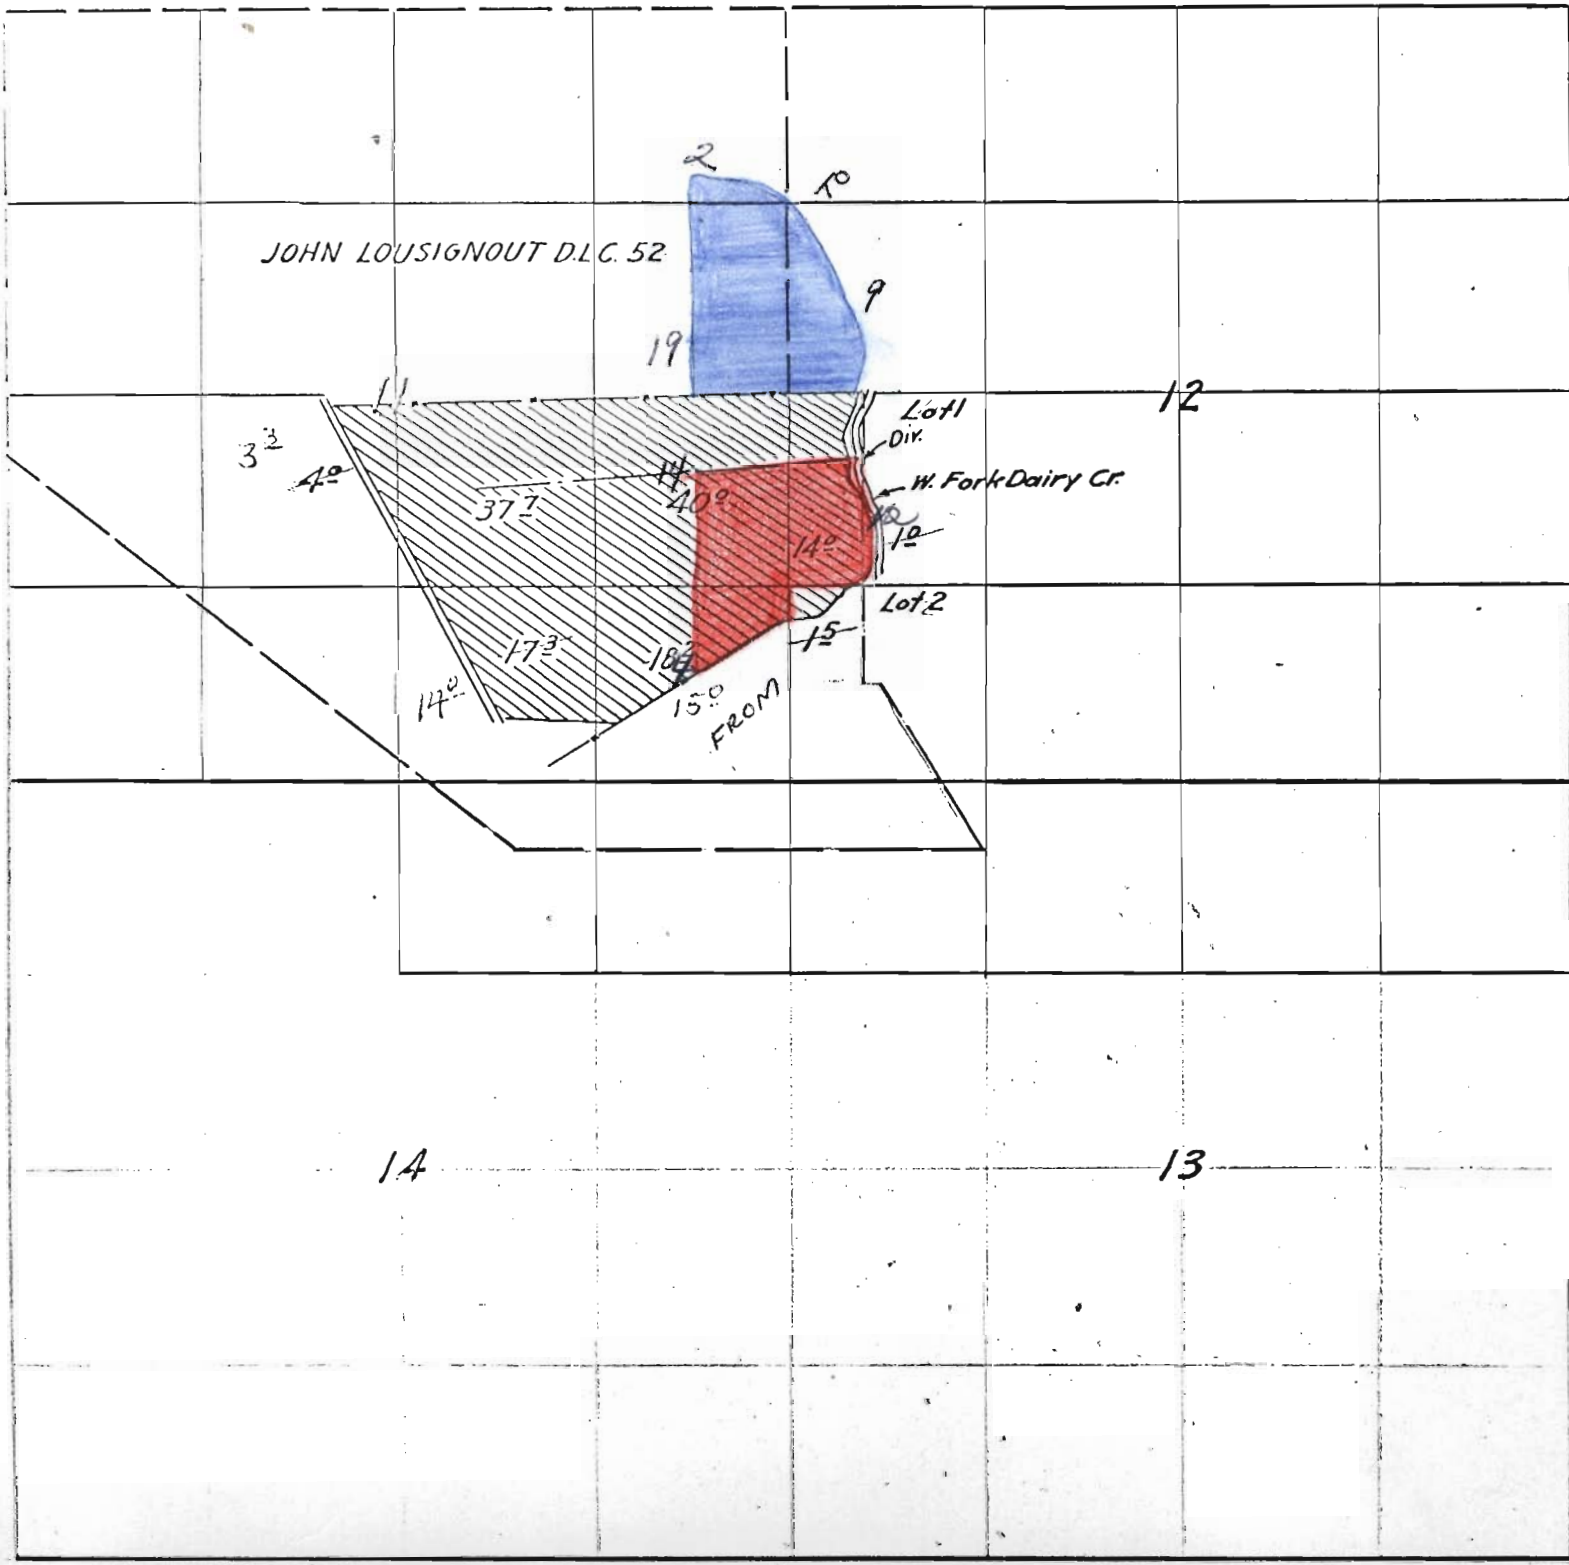

Surveyed Aug. 15, 1941
 Charles Cummings

App. 17702
 Per. 13388