


T. 35 S., R. 4 W., W.M.

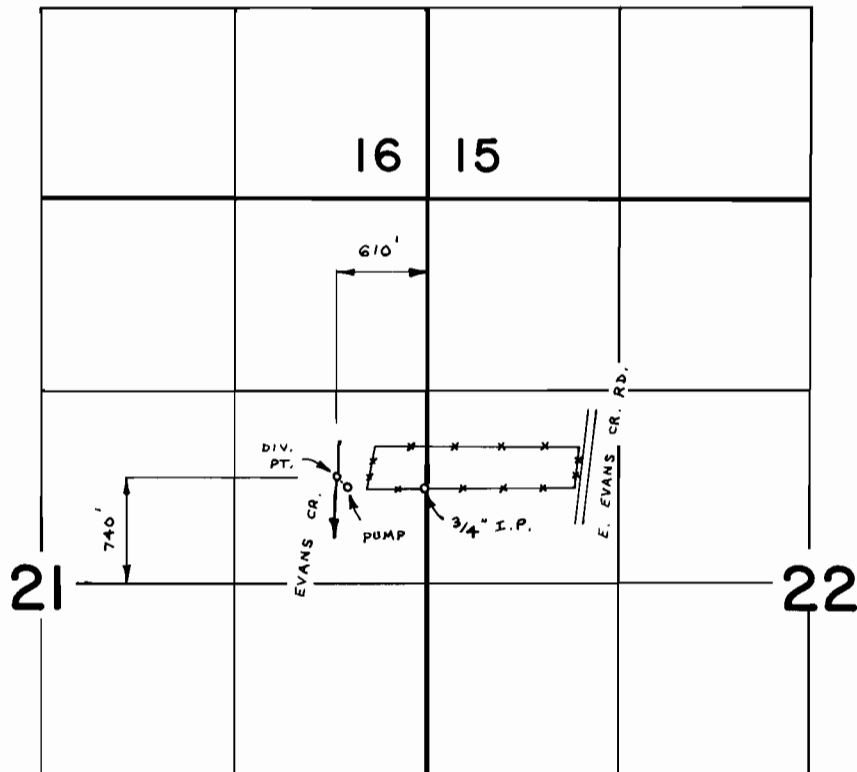

FINAL PROOF SURVEY
UNDER

Transfer No. 2750

Application No. Permit No.

IN NAME OF

JOHN D. & RUTH V. BOYD

Surveyed DEC. 8 77 by B. SUND
19.....

D.H.M.

P.T.S. - 1977 - 14 - B