


T. 1N. R. 10E. W.M.

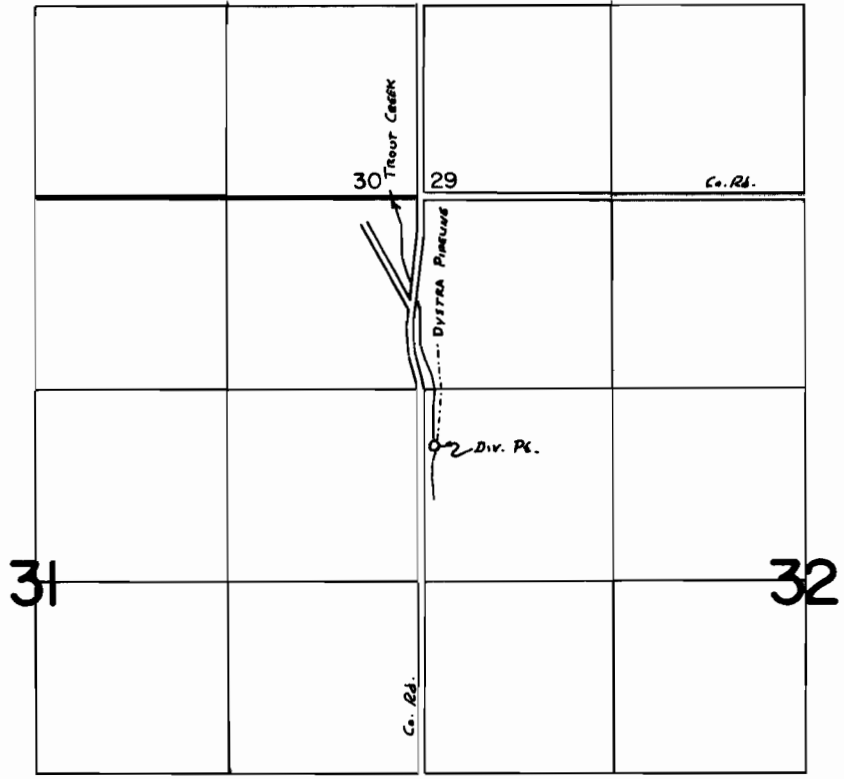

FINAL PROOF SURVEY
UNDER

Transfer No. 2763
Application No. Permit No.
IN NAME OF

MIDDLE FORK IRRIGATION DISTRICT

Surveyed DEC. 22. 19.77., by T. PAUL