


T.5S. R.6W. W.M.

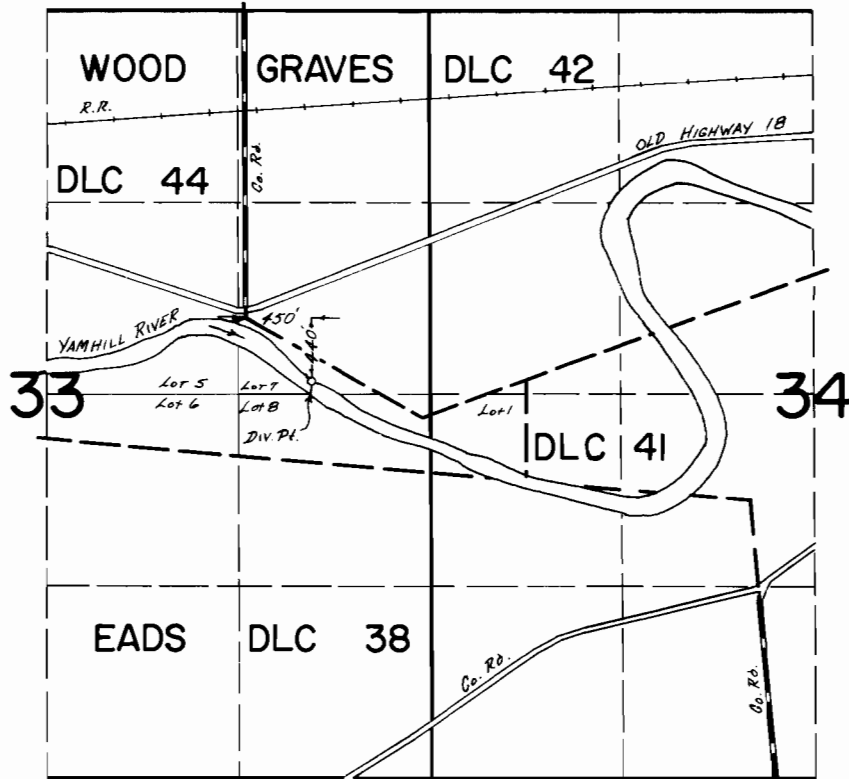

FINAL PROOF SURVEY
UNDER

Transfer No. 2772
Application No. _____ Permit No. _____
IN NAME OF
O. E. SCHELL

Surveyed Oct. 7, 1974, by T. J. PAUL