


T.35S., R.4W., W.M.

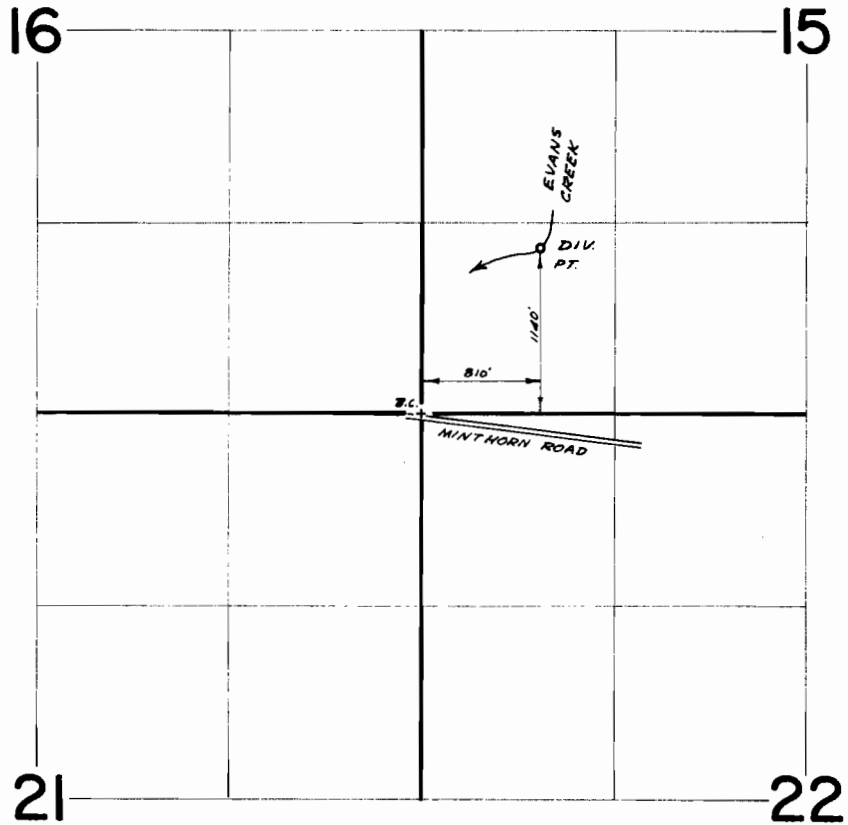

FINAL PROOF SURVEY
UNDER

Transfer No. 2778
Application No. Permit No.

IN NAME OF

ROBERT S. AND DIANA M. CRONHARDT

Surveyed May 6 1975, by D. Norby