


T.3S. R. 9W. W.M.

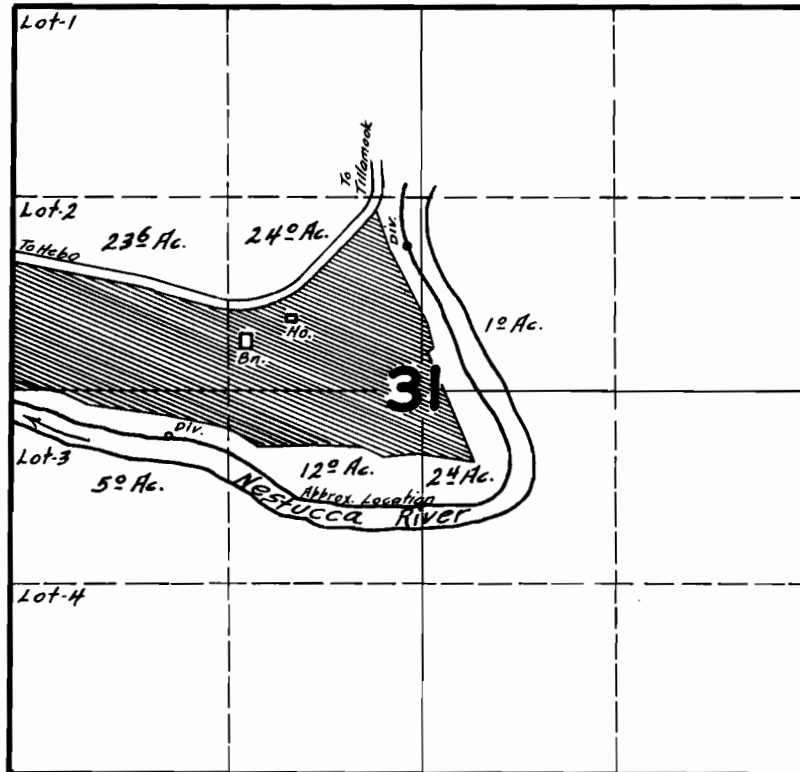

FINAL PROOF SURVEY UNDER

Application No. 19868 Permit No. 15445

IN NAME OF

FRED HALLINGER

Surveyed JULY 17 1946, by

James C. Rummel