


T. 36 S., R. 2 W., W.M.

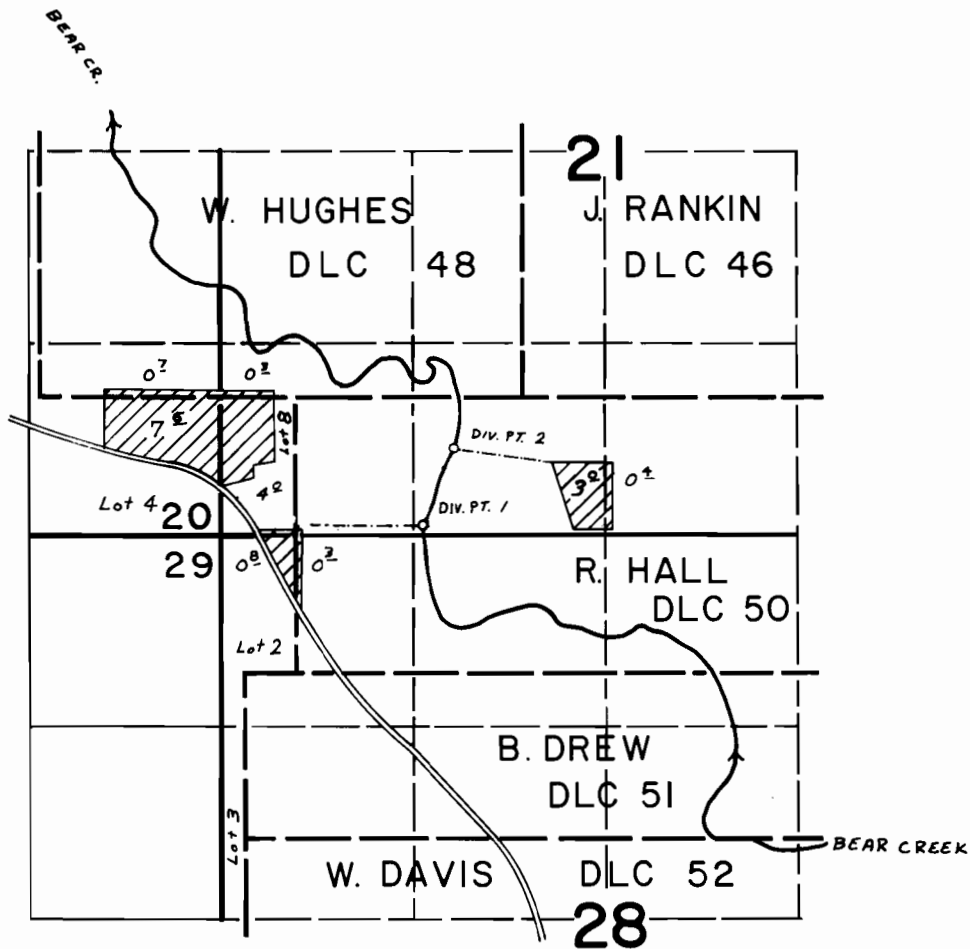

Scale: 4" = 1 mile

FINAL PROOF SURVEY

UNDER

Transfer no. 2785

Application No. Permit No.

IN NAME OF

.....JEANNE S. SAVAGE.....

Surveyed July 28, 1980, by B.R. SUND.....