


T. 1 S. R. 14 E. W. M.

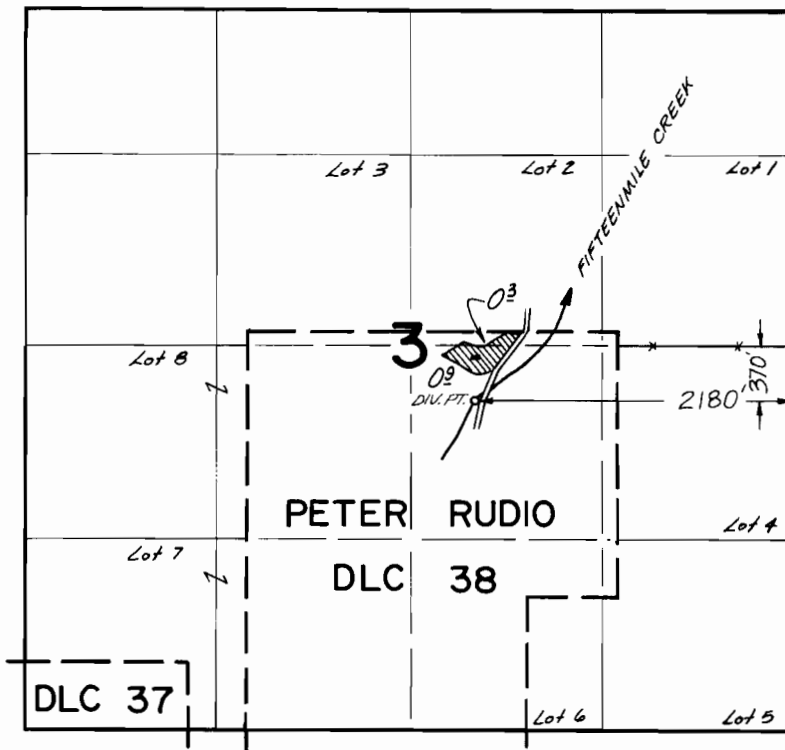

FINAL PROOF SURVEY UNDER

Transfer No. 2790

Application No. Permit No.

IN NAME OF

GEORGE G. FAX

Surveyed JUNE 6, 1975, by R.G. MUCKEN...