


T.36 S. R.6 W. W.M.

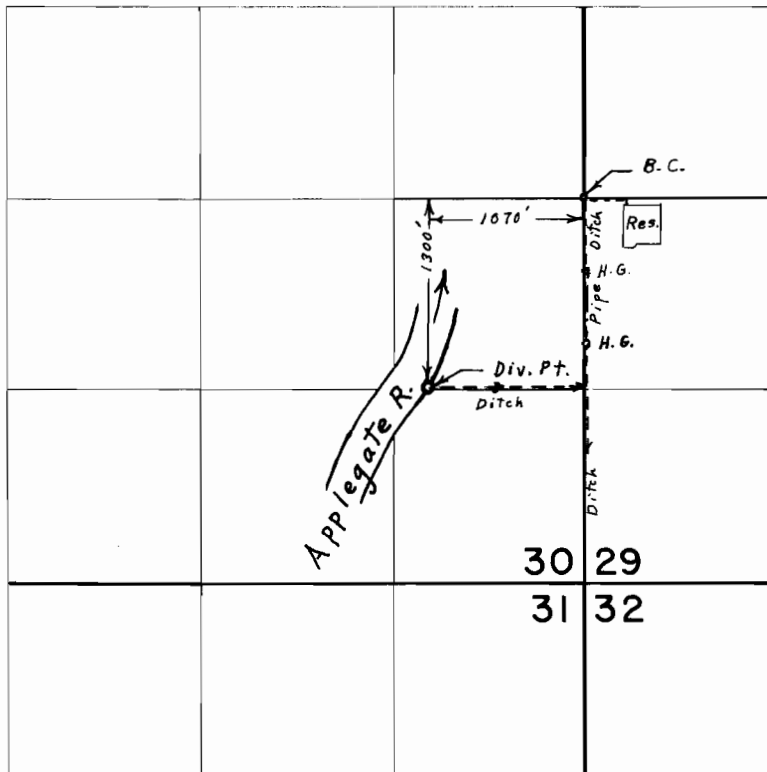

FINAL PROOF SURVEY
UNDER

Application No. _____ Transfer No. 2793
Permit No. _____

IN NAME OF

MERLYN D. BOROUGH

Surveyed *May 20, 1974*, by *L. E. Gould*