


T.2N. R.27E. W.M.

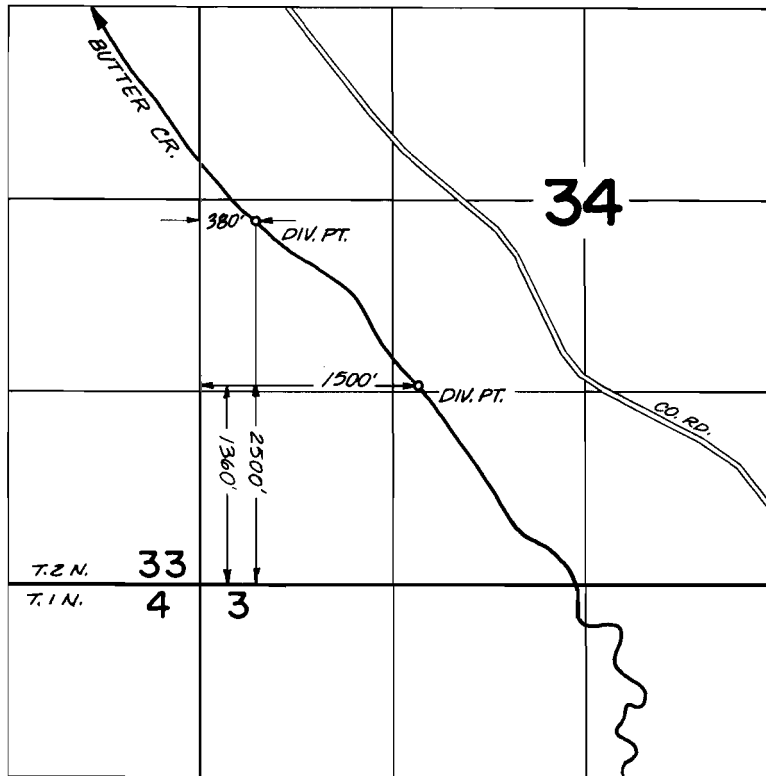

FINAL PROOF SURVEY UNDER

Transfer No. 2794
Application No. _____ Permit No. _____
IN NAME OF

SUSAN E. DOHERTY

Surveyed April 2 1975, by R.G.Mucken