


T. 3 S. R. 1 W. W. M.

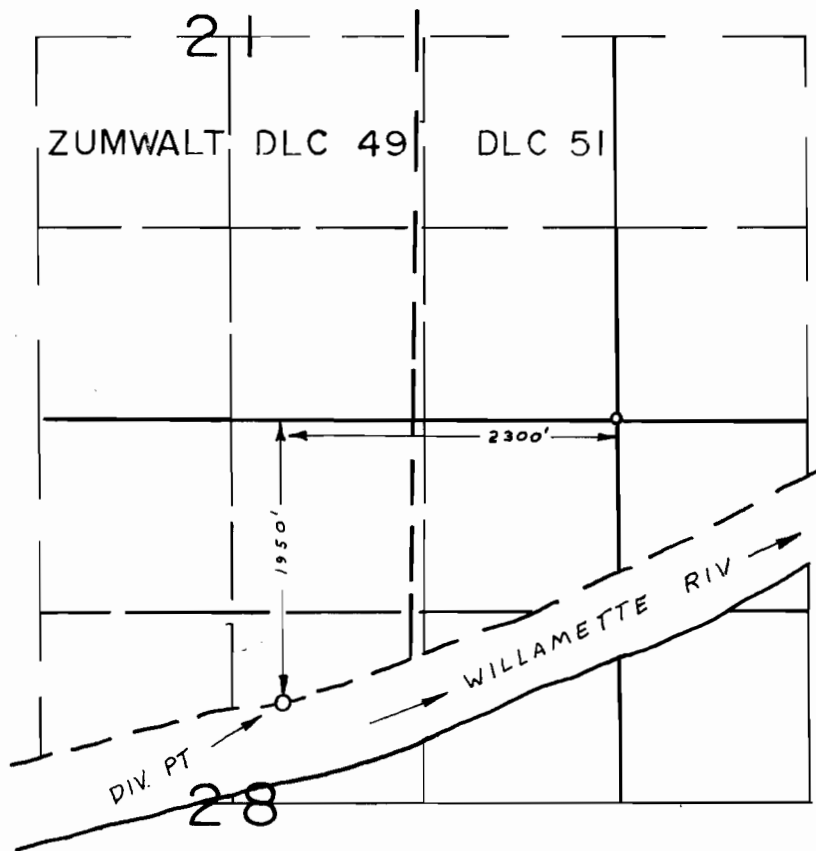

FINAL PROOF SURVEY
UNDER

TRANSFER NO. 2799
Application No. _____ Permit No. _____
IN NAME OF

VIRGINIA AND ELEANOR R. SAY

Surveyed NOV. 6 1974, by L.H. NUNN