


T. 5 S. R. 4 W. W. M.

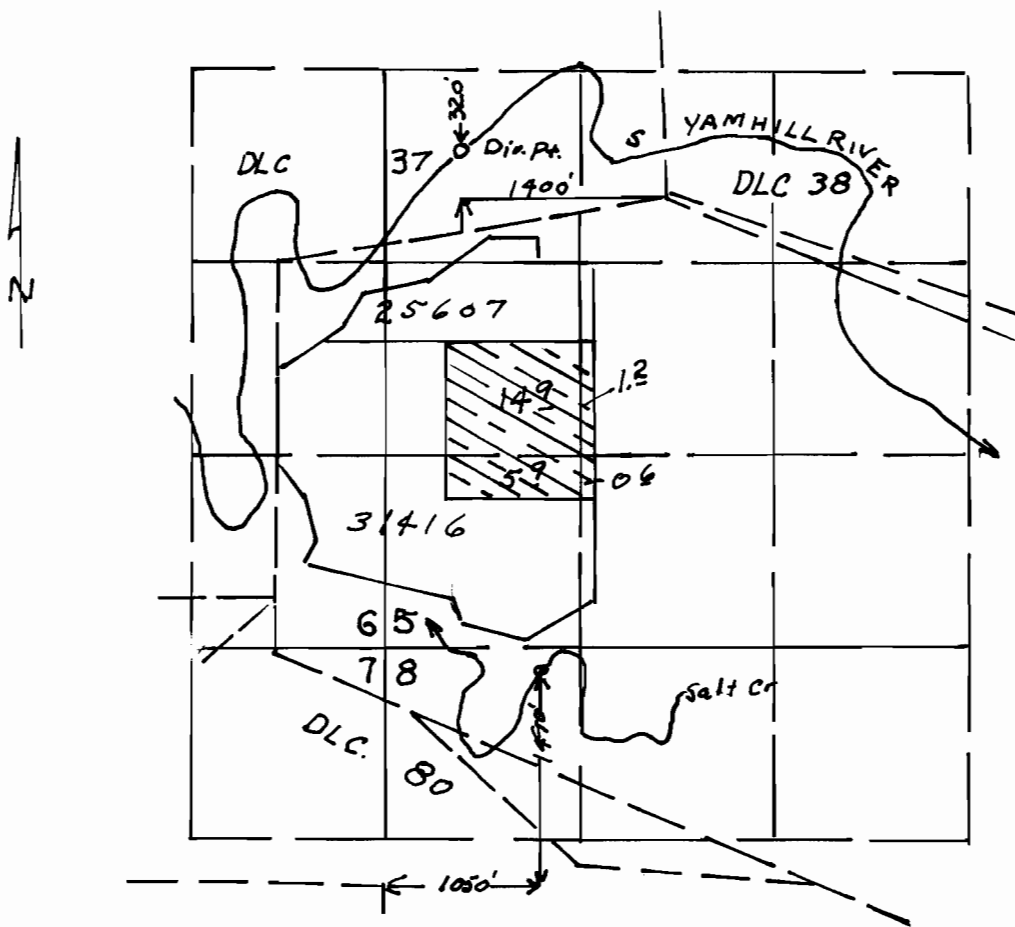

WATER RIGHT TRANSFER
LOCATION MAP
PERMIT NO. 31416

Present place of use