


T.27S. R.6W. W.M.

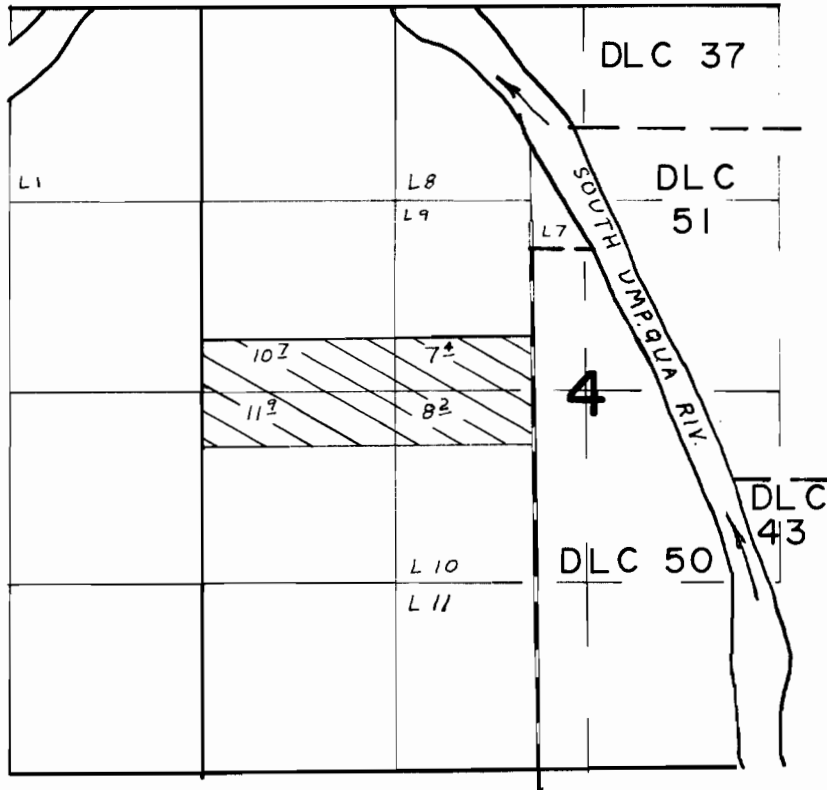

FINAL PROOF SURVEY UNDER

Transfer No. 2812

Application No. Permit No.
IN NAME OF

FRANK GUIDO

Surveyed SEP. 30. 1975., by LH NUNN