


T.39S. R.3W. W.M.

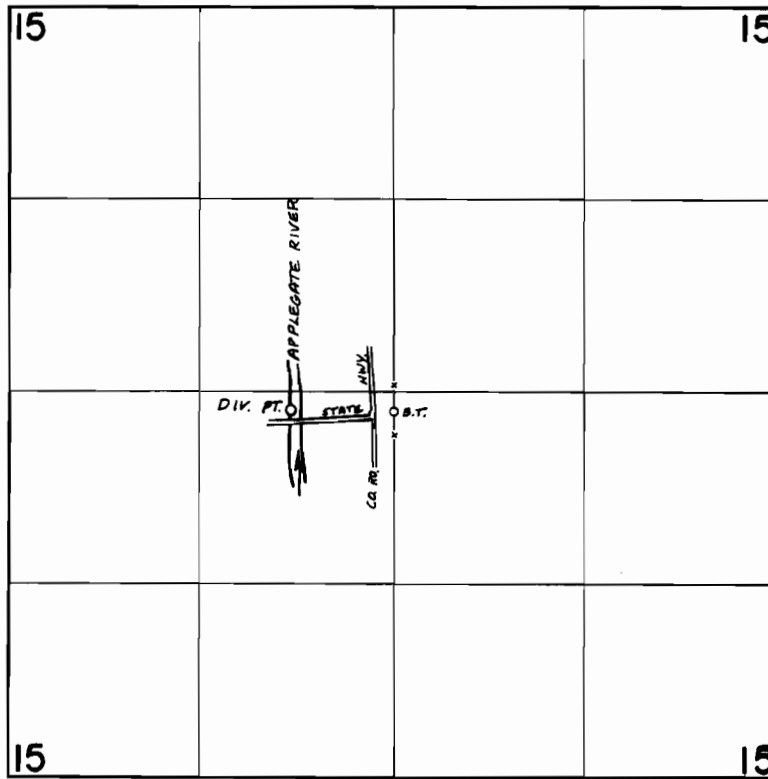

DIV. PT. LOCATED: 130'S. & 710'W. FROM CTR. SEC. 15.

FINAL PROOF SURVEY UNDER

TRANSFER NO. 2817
Application No. _____ Permit No. _____
IN NAME OF

ROBERT E. & SUSAN T. FISHER

Surveyed AUG. 9, 1975, by L. TOLL