


T.5S. R.6W. W.M.

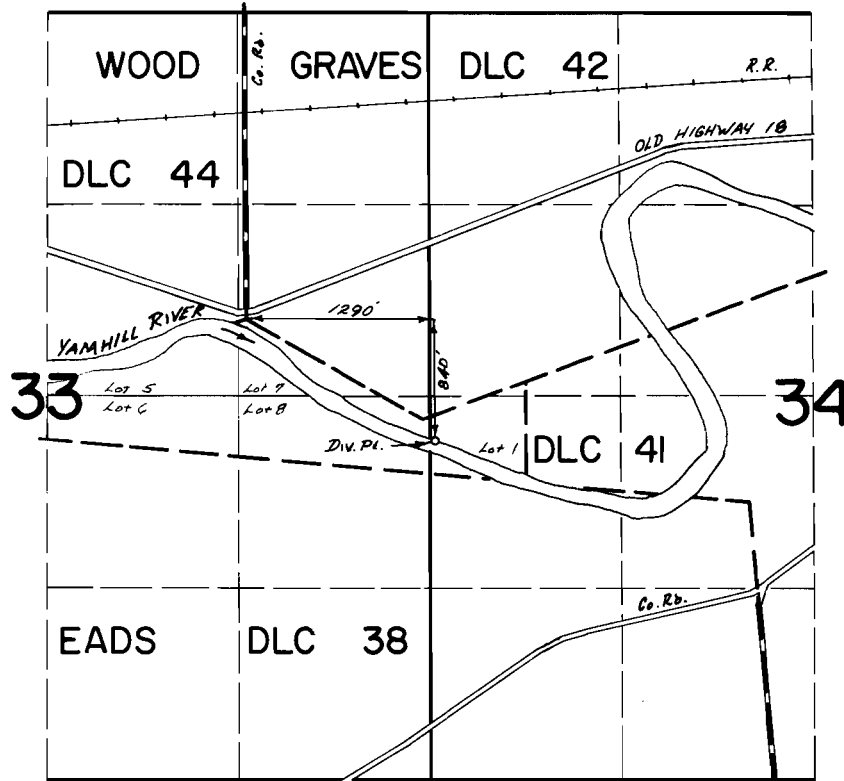

FINAL PROOF SURVEY
UNDER

Transfer No. 2818

Application No. _____ Permit No. _____

IN NAME OF

MR. & MRS. RICHARD E. OLSON

Surveyed Oct. 7, 1974, by T. J. PAUL