


T. 39 S., R. 8 W., W. M.

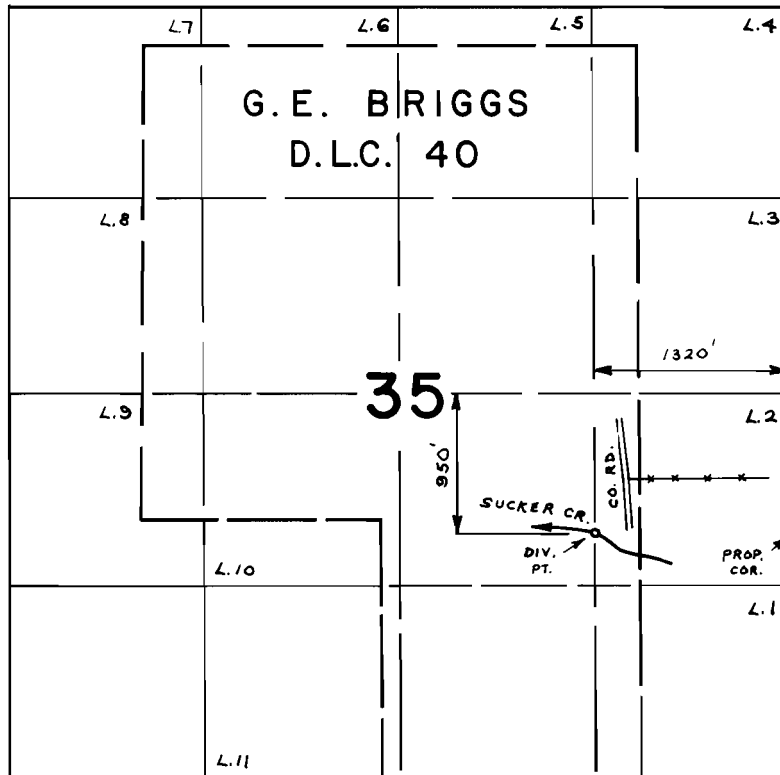

FINAL PROOF SURVEY
UNDER

Transfer No. 2819

Application No. Permit No.
IN NAME OF

CECIL BRUNER

Surveyed AUG. 3 19 78, by B. SUND

D.H.M.

P.T.S. - 1978-14-C