


T. 1 S. R. 10 E. W. M.

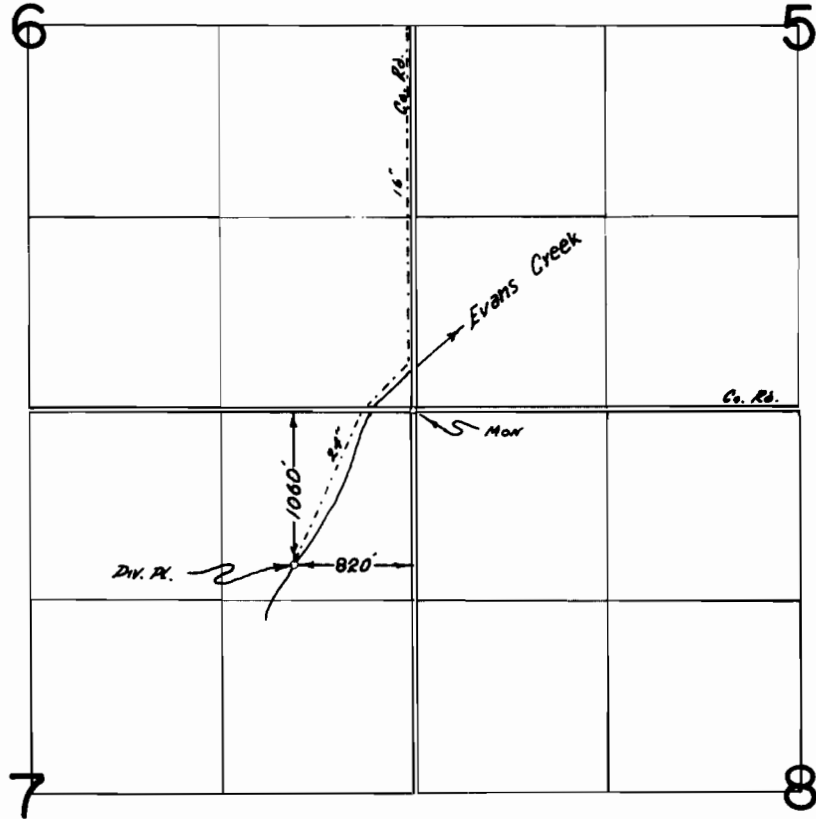

FINAL PROOF SURVEY UNDER

Transfer No. 2823

Application No. Permit No.

IN NAME OF

MIDDLE FORK IRRIGATION DISTRICT

Surveyed JUNE 17 1975, by T. J. POLL