


T.4S. R.1W. W.M.

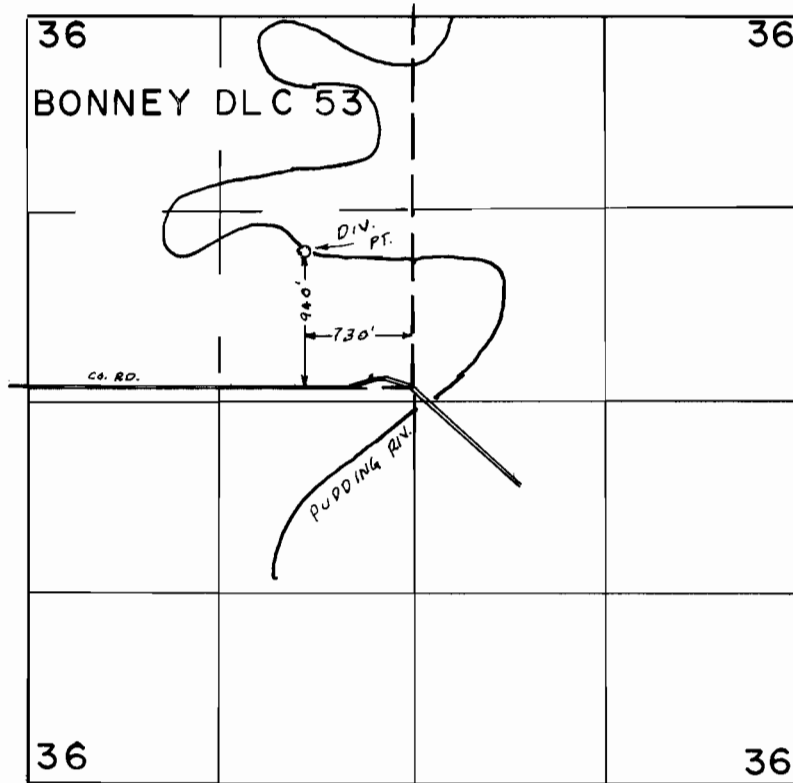

FINAL PROOF SURVEY UNDER

TRANSFER No. 2829

Application No. Permit No.

IN NAME OF

GERALD L. LARSON

Surveyed MAY 21, 1974, by L.H. NUNN