


T.4S. R.1E. W.M.

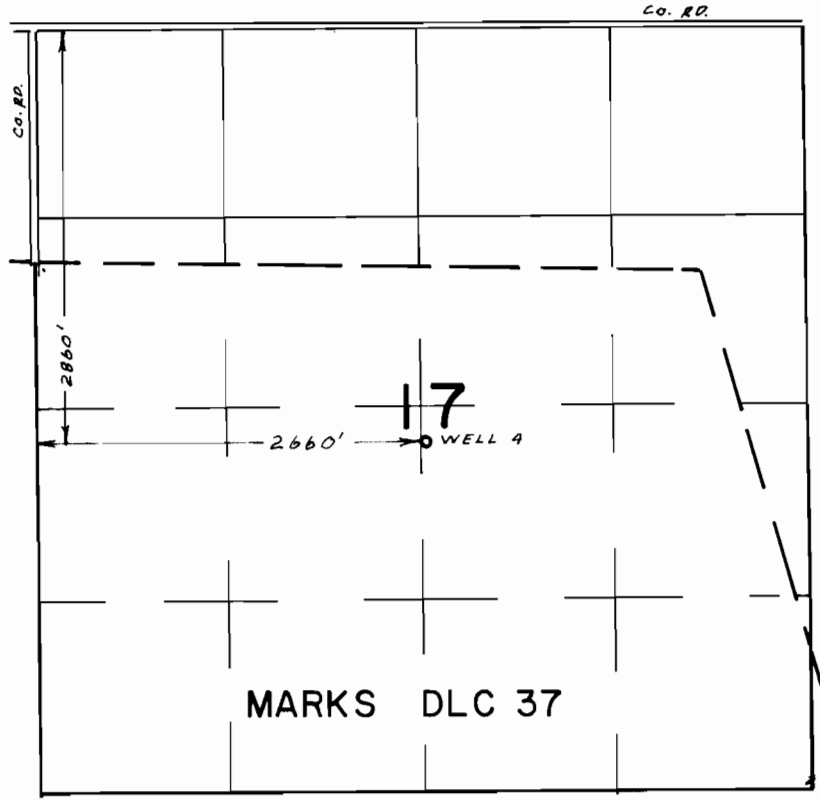

**FINAL PROOF SURVEY**  
UNDER

TRANSFER 3427  
Application No. .... Permit No. ....  
IN NAME OF

J. FRANK SCHMIDT & SON CO.

Surveyed NOV. 10. 1977, by L.H. NUNN.