


T.25S. R.6W. W.M.

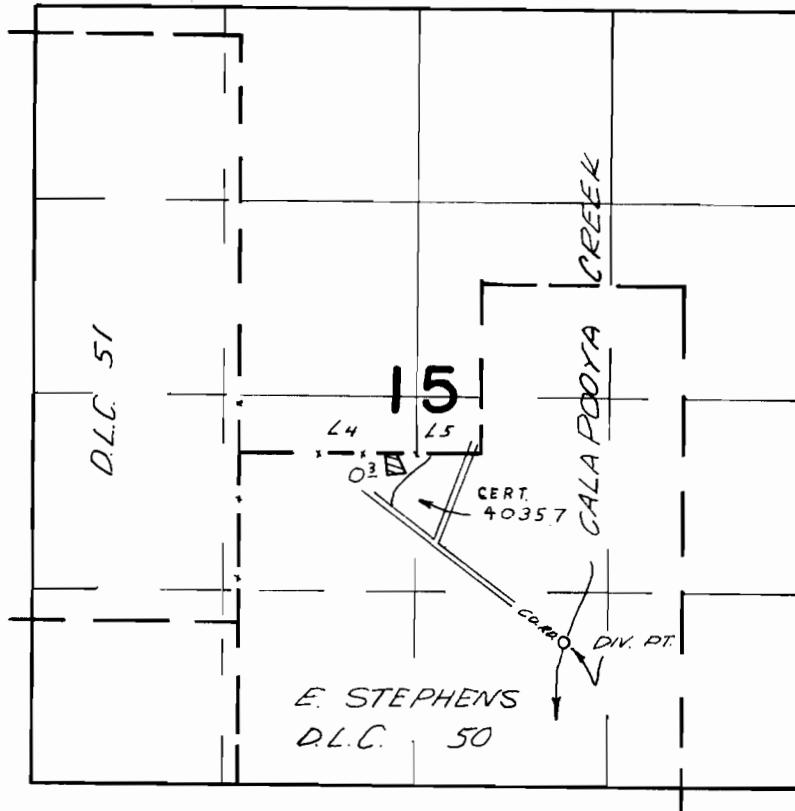

FINAL PROOF SURVEY
UNDER

Transfer No. 2835
Application No. Permit No.

IN NAME OF

..... WALLY MILES

Surveyed SEP. 30 1974, by L.H. NUNN