


16 15
21 22

T 325 R 5 W. W. M.


735'

925'

1" = 200'

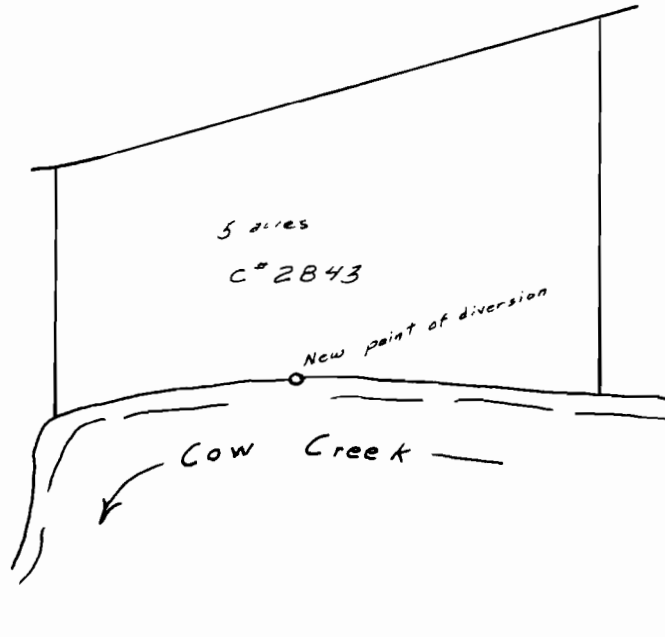

RECEIVED
 JUN 19 1973
 STATE ENGINEER
 SALEM OREGON

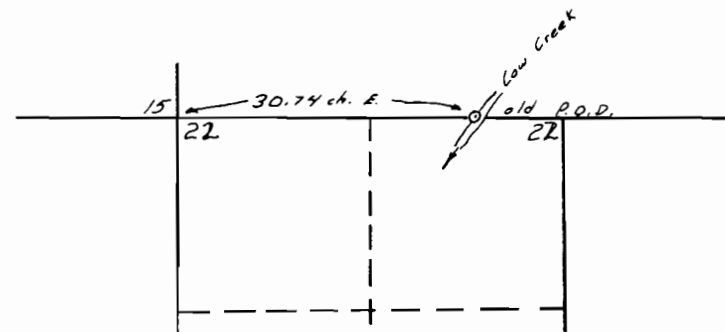

T 325 R 5 W. W. M.

4" = 1 mile