


T.5S. R.1W. W.M.

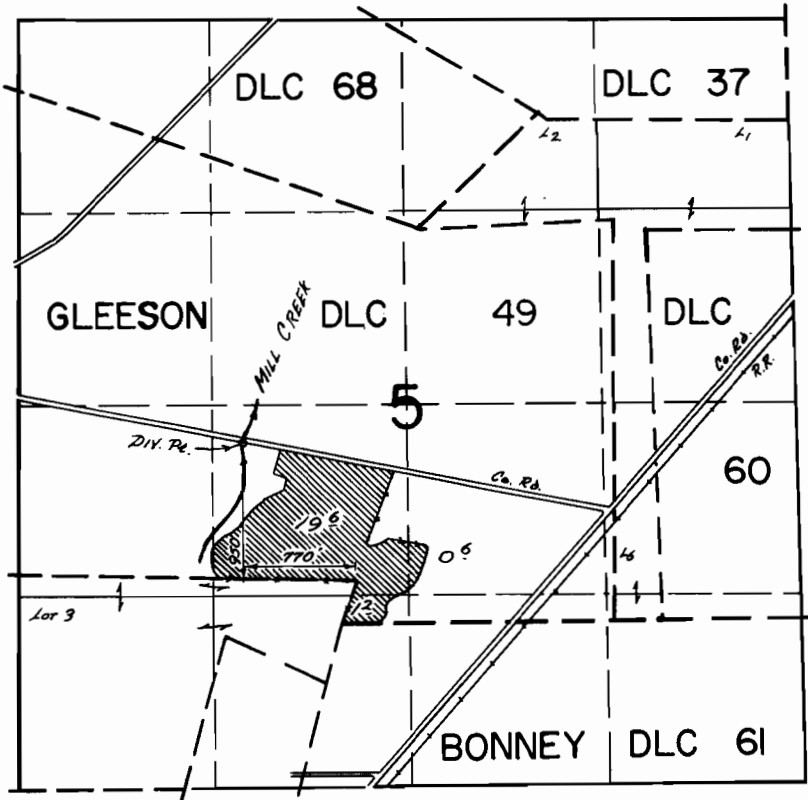

**FINAL PROOF SURVEY**  
UNDER

Transfer No. 2847  
Application No. .... Permit No. ....  
IN NAME OF

..... AMELIA HANAUSKA .....

Surveyed April 10, 1974, by T. J. PAUL .....