


T.18S., R.13E., W.M.

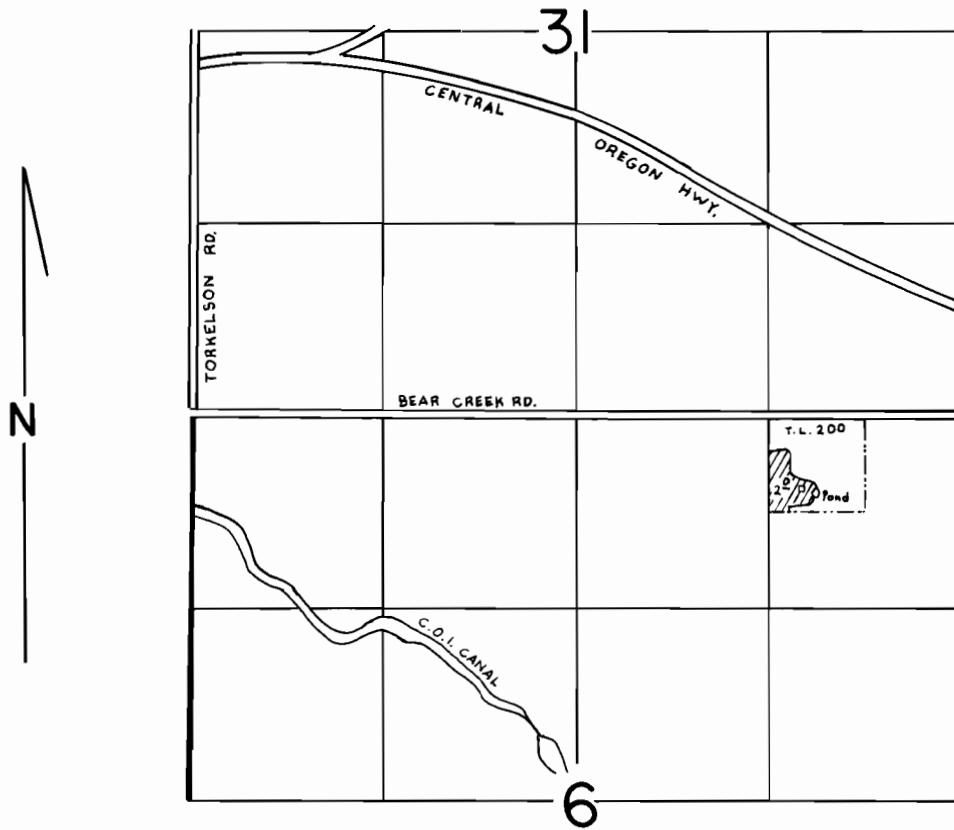

SCALE: 1"=1320'

FINAL PROOF SURVEY
UNDER

TRANSFER NO. 2853

IN NAME OF

GARY BRUNER

Surveyed MAY 9..... 1986., by LESLIE OLSON.....