


T. 3S., R. 4 W., W.M.

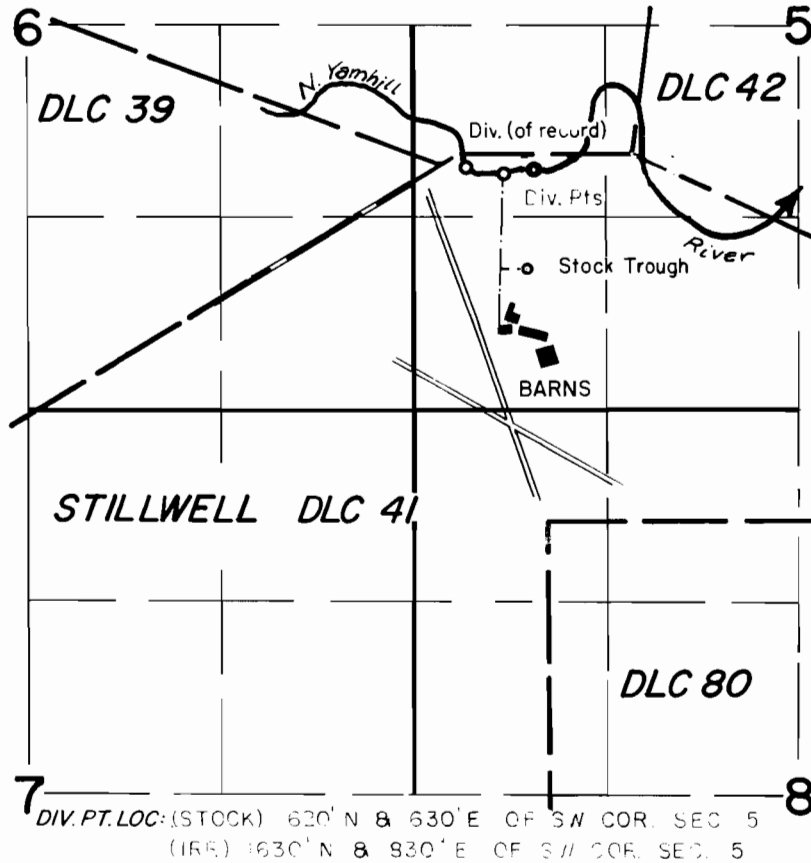

FINAL PROOF SURVEY UNDER

TRANSFERS 2865, 4152, 4250
IN NAME OF
JACK D. FROST

Surveyed Sept. 9, 1977, by *d.c. Brown*
JUL 10, 1984 P. FAGTER