


T.15S. R.10E. W.M.

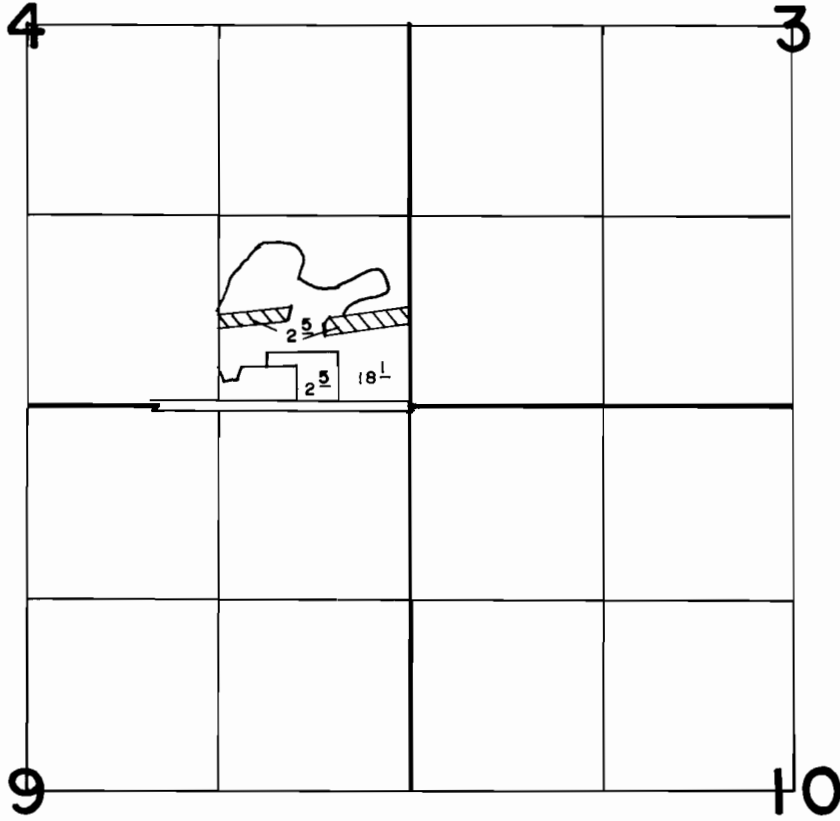

FINAL PROOF SURVEY

UNDER

TRANSFER NO. 2868

Application No. Permit No.

IN NAME OF

.....**MAURICE HUNKING**.....

Surveyed MAY 5 1980., by L.H. NUNN.....