


T. 6S. R. 1E. W.M.

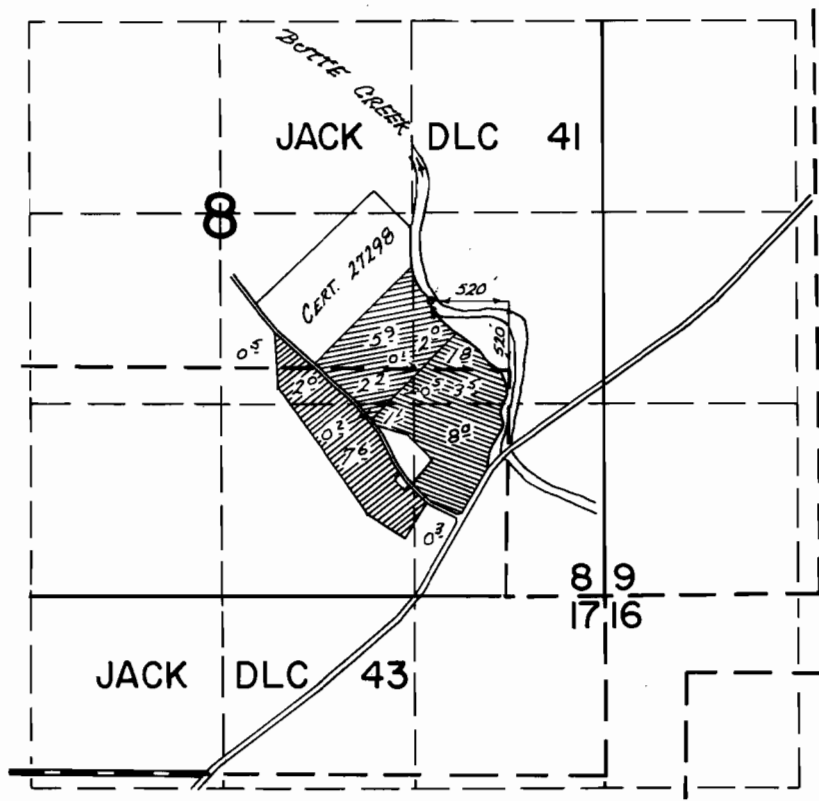

FINAL PROOF SURVEY
UNDER

Transfer Nos. 2875 & 2876
Application No. Permit No.
IN NAME OF

.....
JAMES D. LONG
.....

Surveyed April 10, 1974, by T. J. PAUL.....