


T. 6S. R. 1E. W.M.

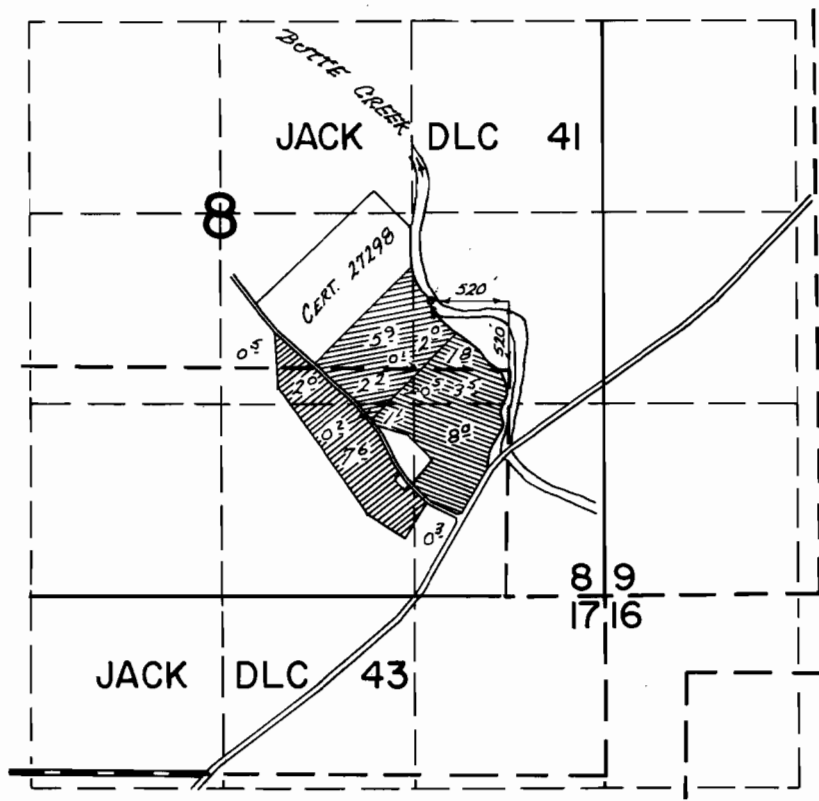

**FINAL PROOF SURVEY**  
UNDER

Transfer Nos. 2875 & 2876  
Application No. .... Permit No. ....  
IN NAME OF

JAMES D. LONG

Surveyed April 10, 1974, by T. J. PAUL