


T.35S., R.3W., W.M.

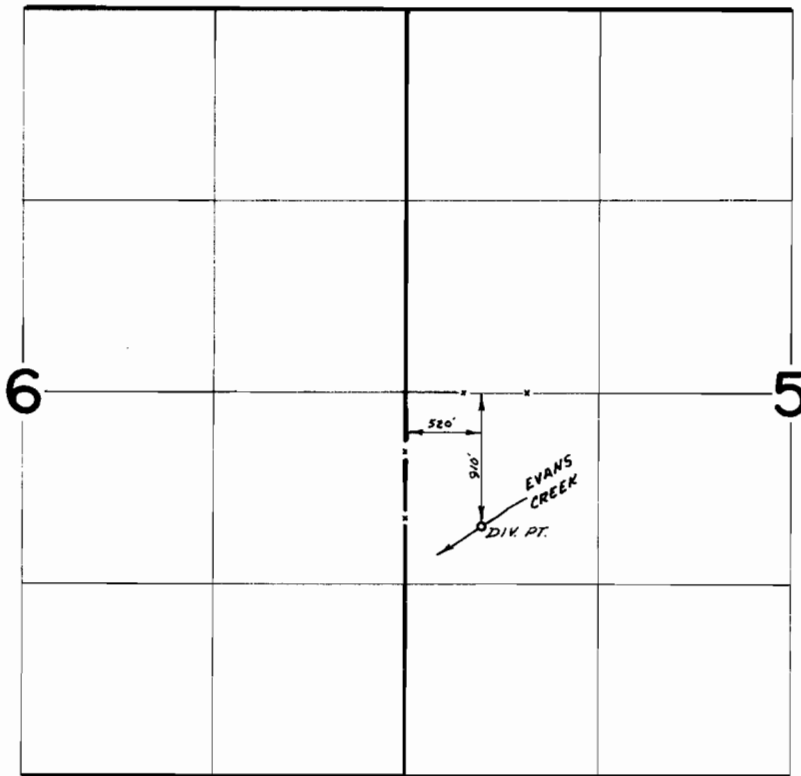

**FINAL PROOF SURVEY**  
UNDER

Transfer No. 2887  
Application No. .... Permit No. ....

IN NAME OF

DEWEY M. BAGLEY

Surveyed May 2 1975, by D. Norby