


T. 5S. R. 2E. W.M.

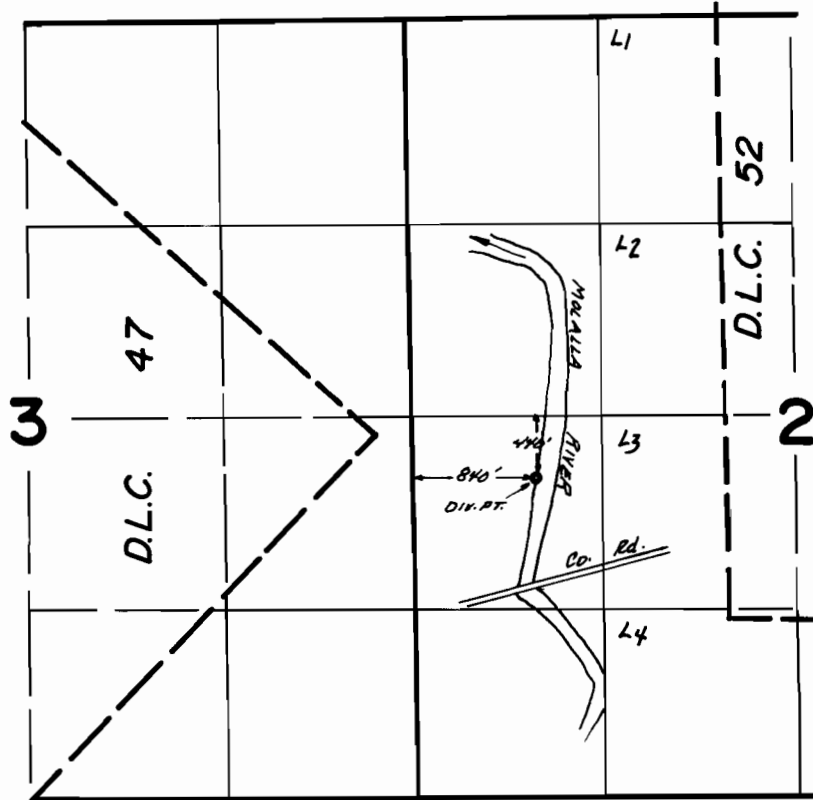

FINAL PROOF SURVEY UNDER

TRANSFER No. 2891
Application No. Permit No.
IN NAME OF

GERALD WHITAKER

Surveyed MAY 3 1978, by J.S. Donaldson