


T.6S.,R.1E.,W.M.

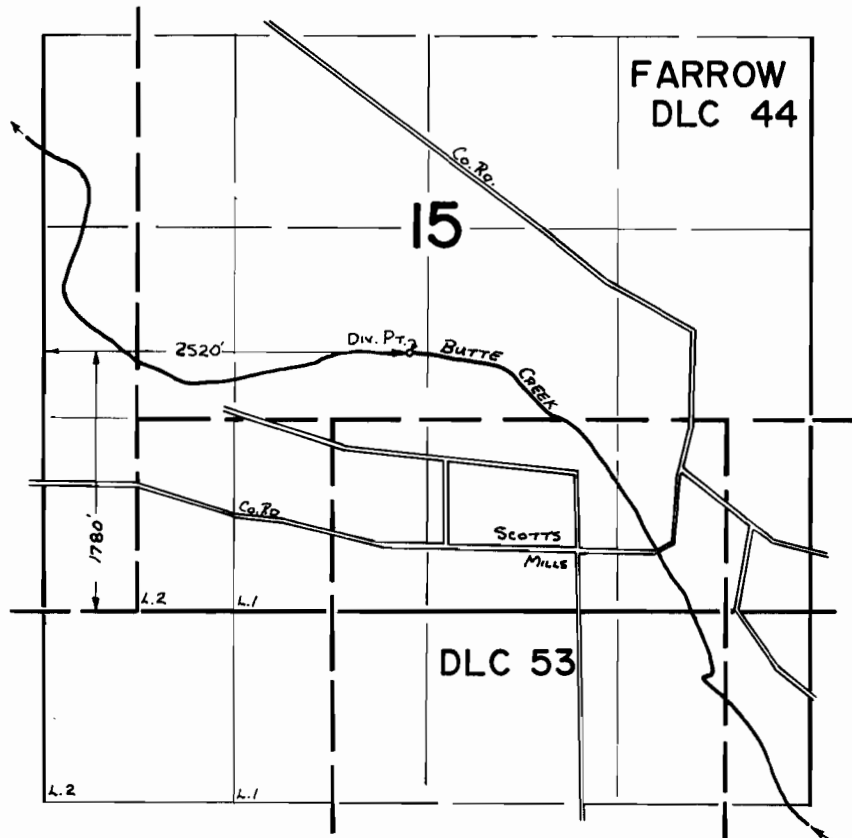

FINAL PROOF SURVEY
UNDER

Transfer No. 2898
Application No. Permit No.
IN NAME OF

ARTHUR ROSENBLAD

Surveyed SEPT. 4, 1974, by L. TOLL