


T.35S., R.4W., W.M.

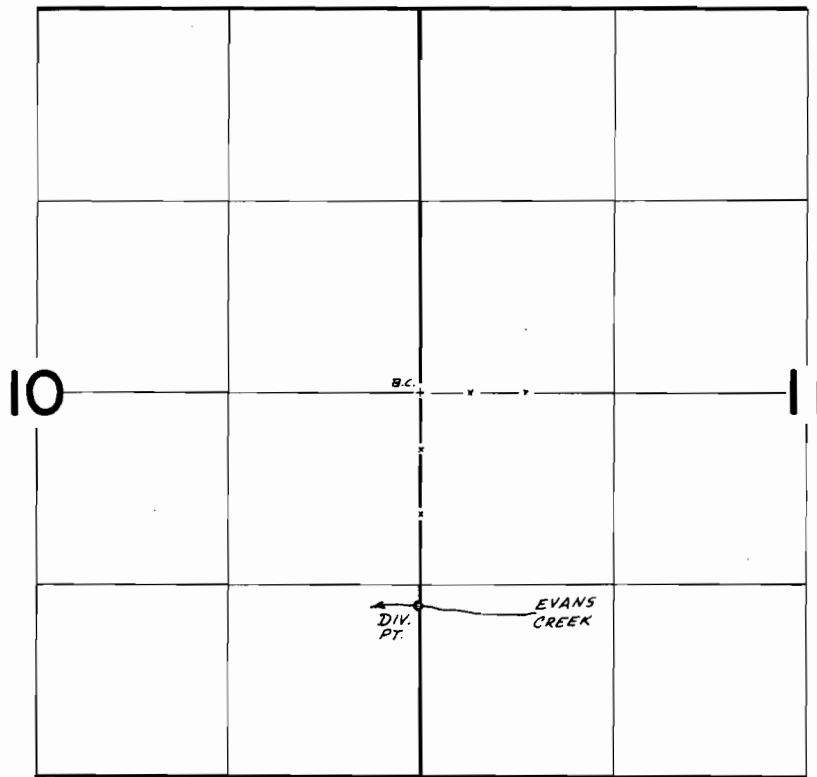

DIV. PT. LOC: 1400' S & 10' W FROM E  $\frac{1}{4}$  COR SEC. 10

**FINAL PROOF SURVEY**  
UNDER

Transfer No. 2902  
Application No. .... Permit No. ....  
IN NAME OF

KENNETH S. JOCHEM

Surveyed May 6 1975, by D. Norby