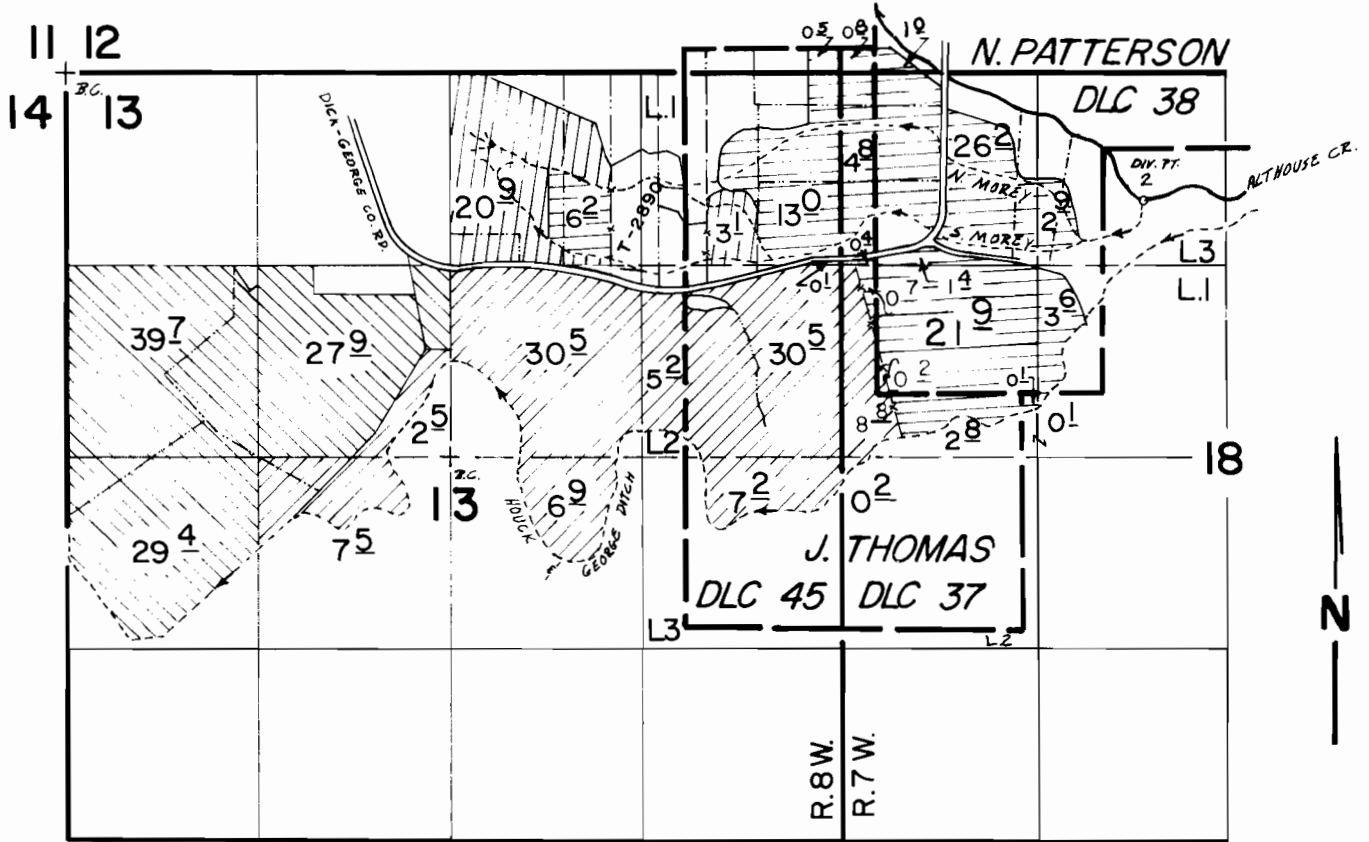


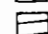
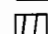


T.40S., R.7 & 8W., W.M.



DIV. PT. 2 : 860'S & 2090'E FROM NORTHWEST COR. OF SEC. 18.

Scale : 4" = 1 Mile

-  CERT. 2713 = 1856
-  CERT. 2715 = 1856
-  CERT. 2713 = 1870
-  CERT. 2715 = 1895

FINAL PROOF SURVEY

UNDER

Transfer No. 2911

Application No. Permit No.

IN NAME OF

..... MRS. GLEN BALES Etal

Surveyed Oct. 9, 1984, by J.R. WOODROOF

