


T.35S. R.IW. W.M.

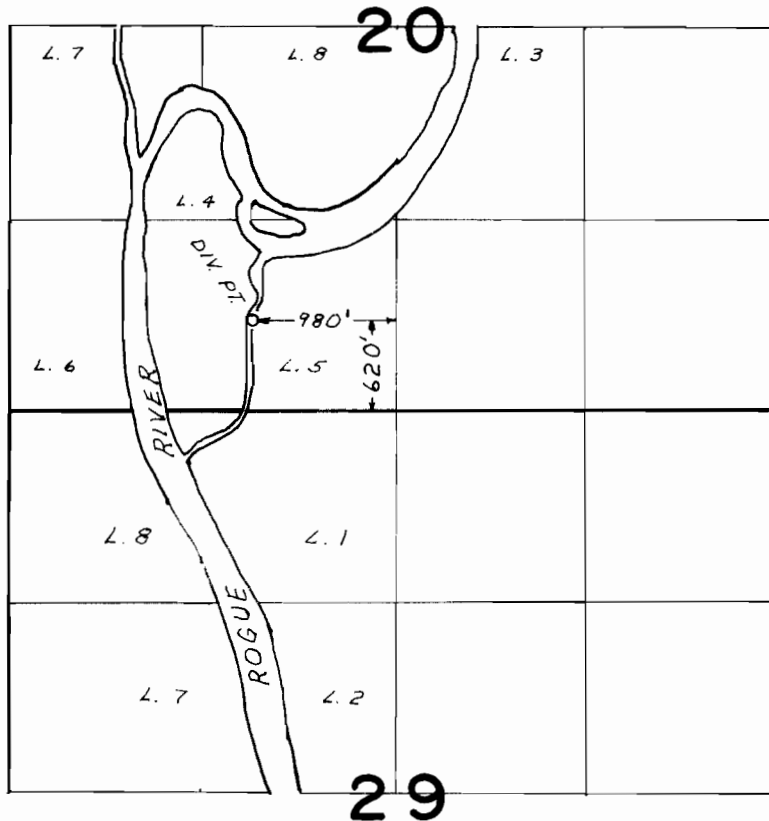

FINAL PROOF SURVEY

UNDER

Transfer No. 2917
2918
2919

Application No. Permit No.

IN NAME OF

ROBERT L. FISHER

Surveyed APR. 24 1975, by LH NUNN