


11/20/73

32-16-12

When State Engineer approves application map should be as below:

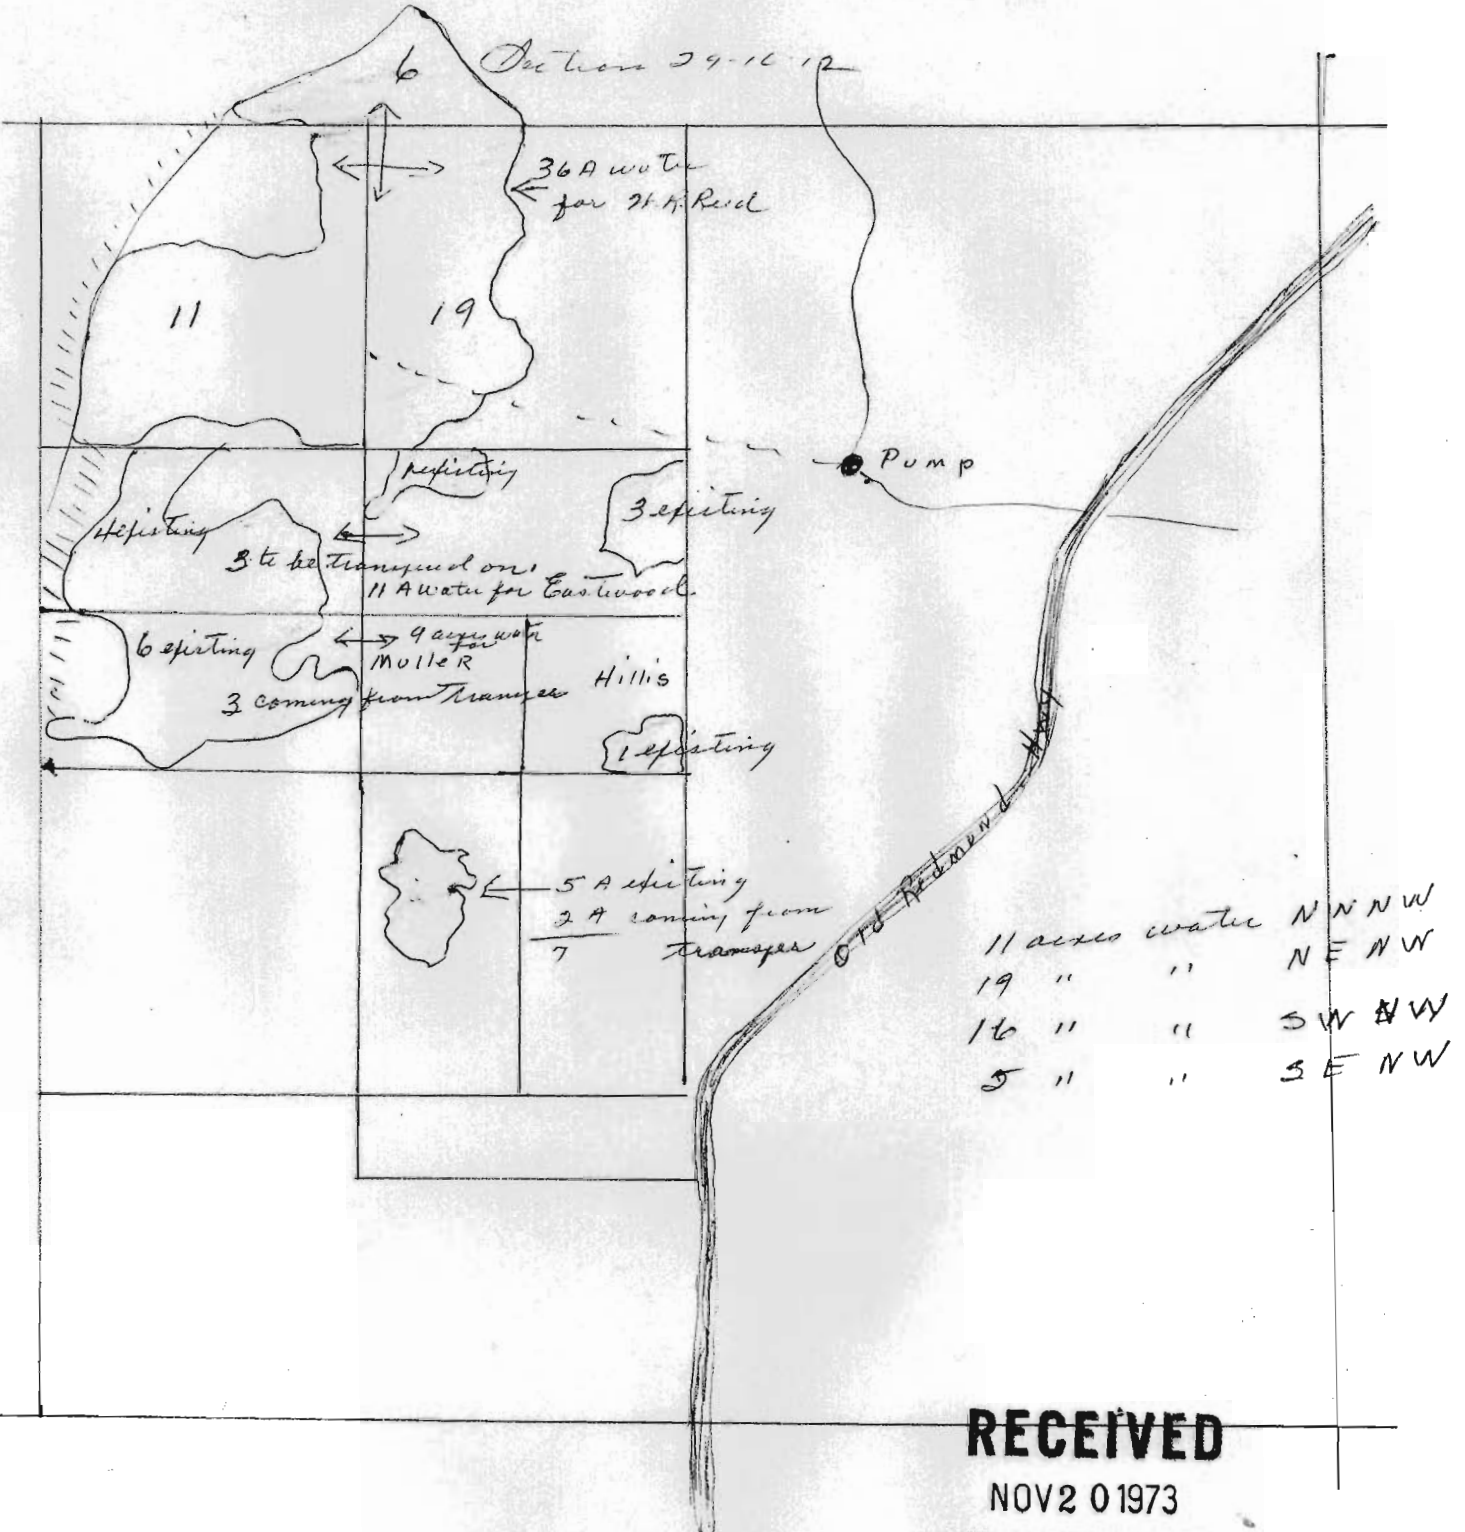

2923

**RECEIVED**

NOV 20 1973

STATE ENGINEER  
SALEM, OREGON