


to map

SEC. 21 TWP 16S RANGE 11E

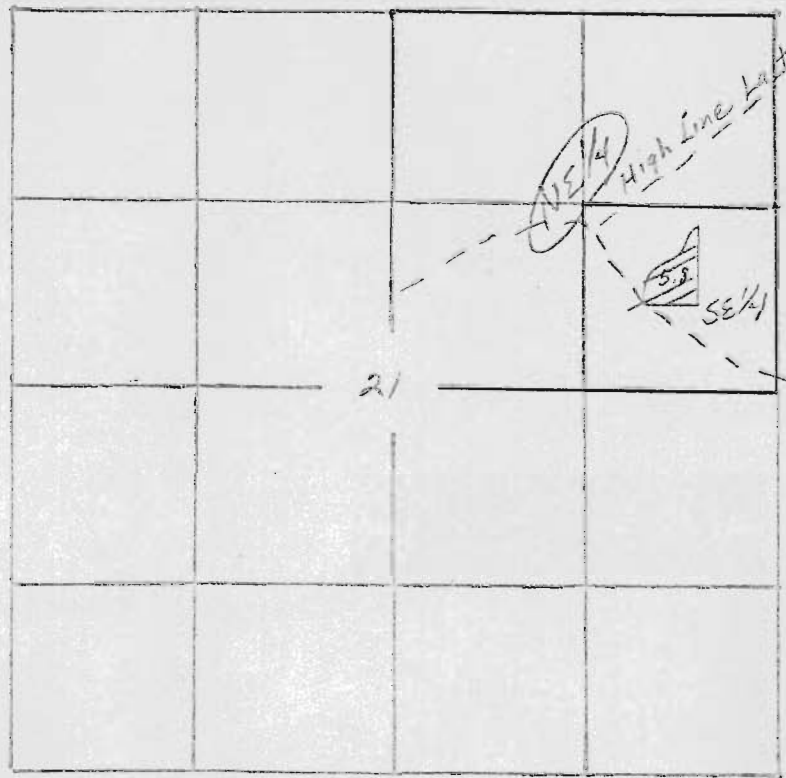

RECEIVED

DEC 4 1978

WATER RESOURCES DEPT.
SALEM, OREGON

Jack Vogt transferred off; 5.8 ac.

TRANSFERRED FROM: SE 1/4 NE 1/4 SEC. 10 TWP. 16S R. 12 E

Transferred to D. Goldy 5.8 ac.

TRANSFERRED TO: SE 1/4 NE 1/4 SEC. 21 TWP. 16S R. 11E