



T.16S.,R.IIE.

T.17S.,R.IIE.


T.17S.,R.IIE.

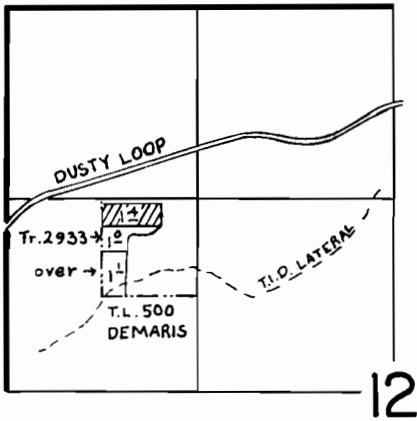


12

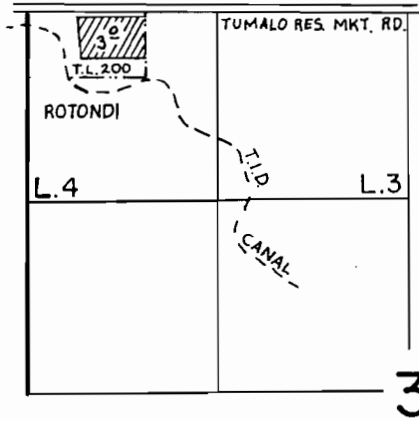

3

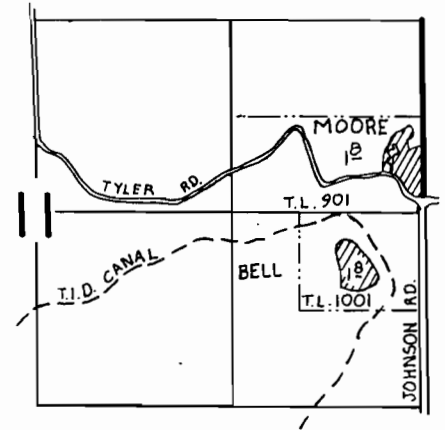
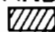


T.16S.,R.IIE.,W.M.

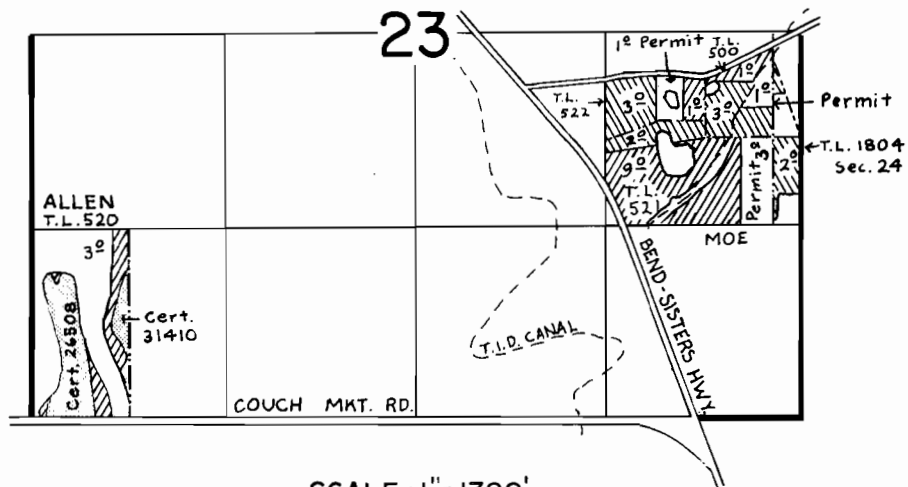

SCALE : 1" = 1320'

### FINAL PROOF SURVEY

UNDER   
TRANSFER NO. 5640 AND  
PART OF TRANSFER NO. 3872 

IN NAME OF  
**TUMALO I.D. & VARIOUS OWNERS**

Surveyed APRIL 3, 1986, by LESLIE OLSON and  
thru JUNE 16 1986 M. J. MATTICK

v 35 p.236  
v. 39 p.244