


T.16S., R.12E., W.M.

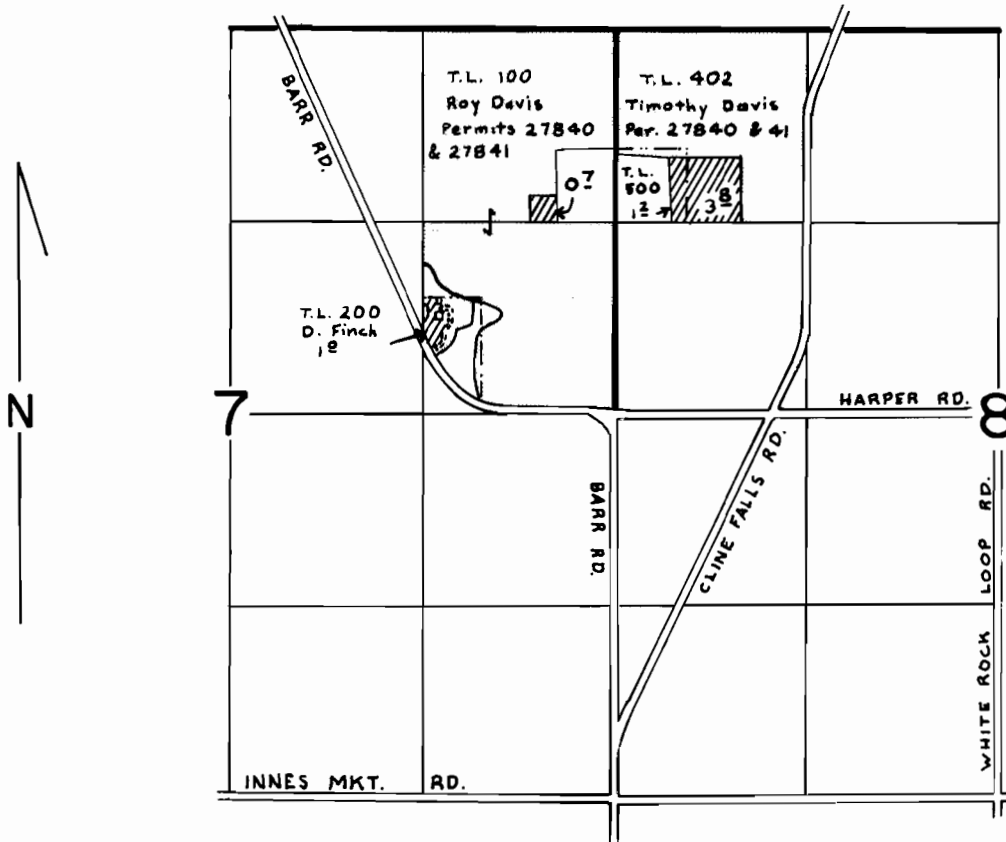

SCALE: 1" = 1320'

FINAL PROOF SURVEY UNDER

TRANSFER NO. 2939

IN NAME OF

ROY DAVIS et al.

Surveyed APRIL 7, 1986., by LESLIE OLSON.....