


T. 40S., R. 4E., W.M.

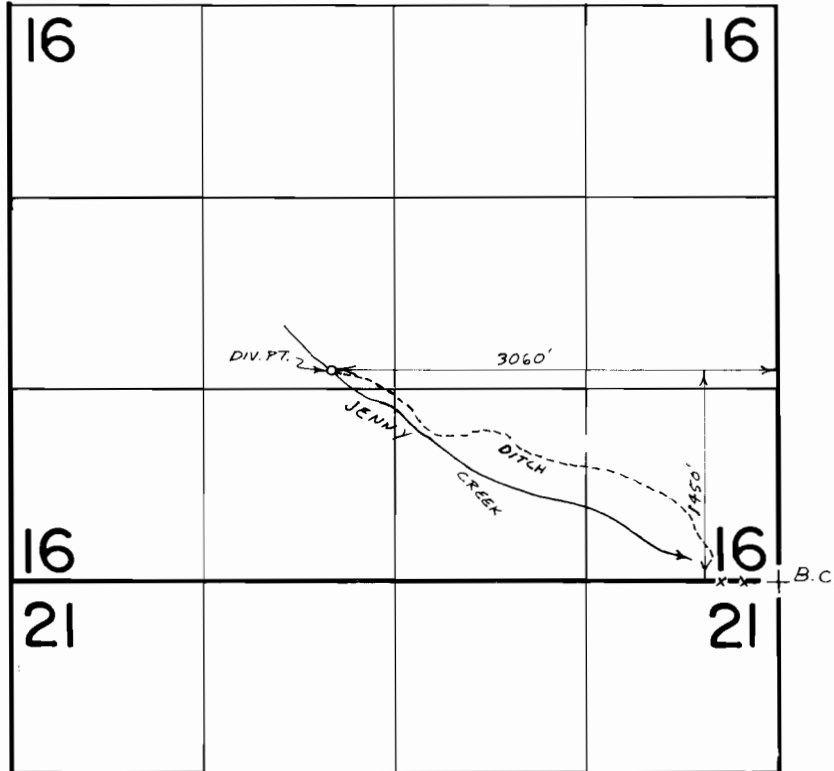

FINAL PROOF SURVEY
UNDER

Transfer No. 2943

Application No. Permit No.

IN NAME OF

JOHN & MARILYN MOSBY

Surveyed Sept. 10, 1980, by Bruce R. Sund