


T.36 S., R.4 W., W.M.

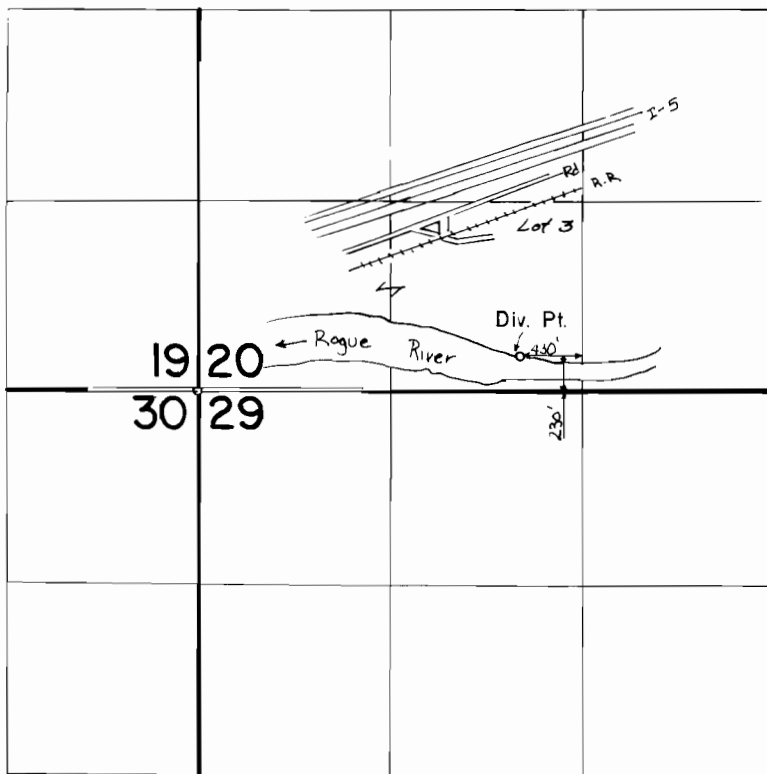

FINAL PROOF SURVEY UNDER

TRANSFER NO. 2948

IN NAME OF

JAMES P. OLMSTED

Surveyed APRIL 22, 1983, by B. S. JAMES